

RECEIVED
CONTRACT MANAGEMENT

CHANGE ORDER APPROVAL FORM

2011 JAN 19 PM 4:17

PROJECT: CR121 Pond Reconstruction CHANGE ORDER NUMBER: 02

DATE: 12/29/10

CONTRACT NUMBER: CM1653

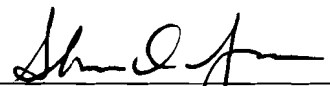
TO CONTRACTOR: Northpointe Services, Inc.

Reason for Change Order: Pond reconfiguration to control erosion and maintain existing drainage flows.

Original Contract Sum.....	\$	<u>132,955.75</u>
Net Change by Previous Change Order/Supplemental Agreement.	\$	<u>(27.65)</u>
Contract Sum Prior to This Change Order.....	\$	<u>132,928.10</u>
Amount of This Change Order (Add/Deduct).....	\$	<u>17,425.65</u>
New Contract Sum Including this Change Order.....	\$	<u>150,353.75</u>

2011 JAN 20 PM 2:19


(Need BT from Res.)

APPROVED BY: 
Shanea Jones, Office of Management & Budget

DATE: 1-21-11

APPROVED BY: 
Ted Selby, County Manager

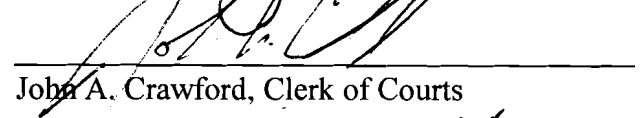
DATE: 1/21/11

APPROVED BY: 
David Hoffman, County Attorney

DATE: 1/31/11

APPROVED BY: 
Walter J. Boatright, Chair

DATE: 2/28/11

APPROVED BY: 
John A. Crawford, Clerk of Courts

DATE: 3/3/11

*ea
2/28/11*

2011 JAN 24 AM 10:25

RECEIVED

RECEIVED

received
 11/21/11
 included in Pay app. 4 & 5

CHANGE ORDER REQUEST FORM

PROJECT: CR 121 Pond Reconstruction

No. 2

DATE OF ISSUANCE:

EFFECTIVE DATE:

NASSAU COUNTY BOARD OF COUNTY COMMISSIONERS

COUNTY Contract / Purchase Order No.: CM1653/11000002-01

CONTRACTOR: Northpointe Services, Inc.

ENGINEER / ARCHITECT: Ayres Associates

You are directed to make the following changes in the Contract Documents.

Description: See Attached

Reason for Change Order: Pond reconfiguration to control erosion and maintain existing drainage flows.

Attachments: Preliminary As-Built, Schedule of Values, CO No. 2 Pay Item Summary w/explanation notes.

<p>CHANGE IN CONTRACT PRICE:</p> <p>Original Contract Price</p> <p>\$ <u>132,955.75</u></p>	<p>CHANGE IN CONTRACT TIMES:</p> <p>Original Contract Times</p> <p>Substantial Completion: <u>60</u></p> <p>Ready for Final Payment: <u>105</u> (days or dates)</p>
<p>Net change from previous Change Orders No. <u>1</u> to No. <u>1</u></p> <p>\$ <u>(27.65)</u></p>	<p>Net change from previous Change Orders No. <u>1</u> to No. <u>1</u></p> <p><u>0</u> (days)</p>
<p>Contract Price prior to this Change Order</p> <p>\$ <u>132,928.10</u></p>	<p>Contract Times Prior to this Change Order</p> <p>Substantial Completion: <u>60</u></p> <p>Ready for Final Payment: <u>105</u> (days or dates)</p>
<p>Net Increase (decrease) of this Change Order</p> <p>\$ <u>17,425.65</u></p>	<p>Net Increase (decrease) of this Change Order</p> <p><u>0</u> (days)</p>
<p>Contract Price with all approved Change Orders</p> <p>\$ <u>150,353.75</u></p>	<p>Contract Times with all approved Change Orders</p> <p>Substantial Completion: <u>60</u></p> <p>Ready for Final Payment: <u>105</u> (days or dates)</p>

RECOMMENDED:
 X By: [Signature]
 Engineer/Architect (Authorized Signature)
 Date: 1/3/11

APPROVED:
 By: [Signature]
 COUNTY (Authorized Signature)
 Date: 1/2/11

ACCEPTED:
 By: [Signature] JEREMY CALDWAY
 Contractor (Authorized Signature)
 Date: 12/29/10

CR 121 POND RECONSTRUCTION - CHANGE ORDER NO. 2 PAY ITEM SUMMARY
12/28/2010

ITEM	DESCRIPTION	QUANTITY	UNIT	UNIT PRICE	AMOUNT
	DELETE FROM CONTRACT				
104-13-1	Staked Silt Fence, Type III	(199.00)	LF	\$ 0.85	\$ (169.15)
120-1A	Regular Excavation	2331.00	CY	\$ 4.80	\$ 11,188.80
530-3-4	RipRap Rubble	12.50	TN	\$ 125.00	\$ 1,562.50
570-1-2	Performance Turf, Sod	1024.00	SY	\$ 1.85	\$ 1,894.40
570-1-2	Seed and Mulch	887.00	SY	\$ 0.40	\$ 354.80
-	ProPex Landlok 450	301.00	SY	\$ 4.30	\$ 1,294.30
-	Re-Mobilization & Delivery, Additional RipRap	1.00	LS	\$ 1,300.00	\$ 1,300.00
	Total				\$ 17,425.65

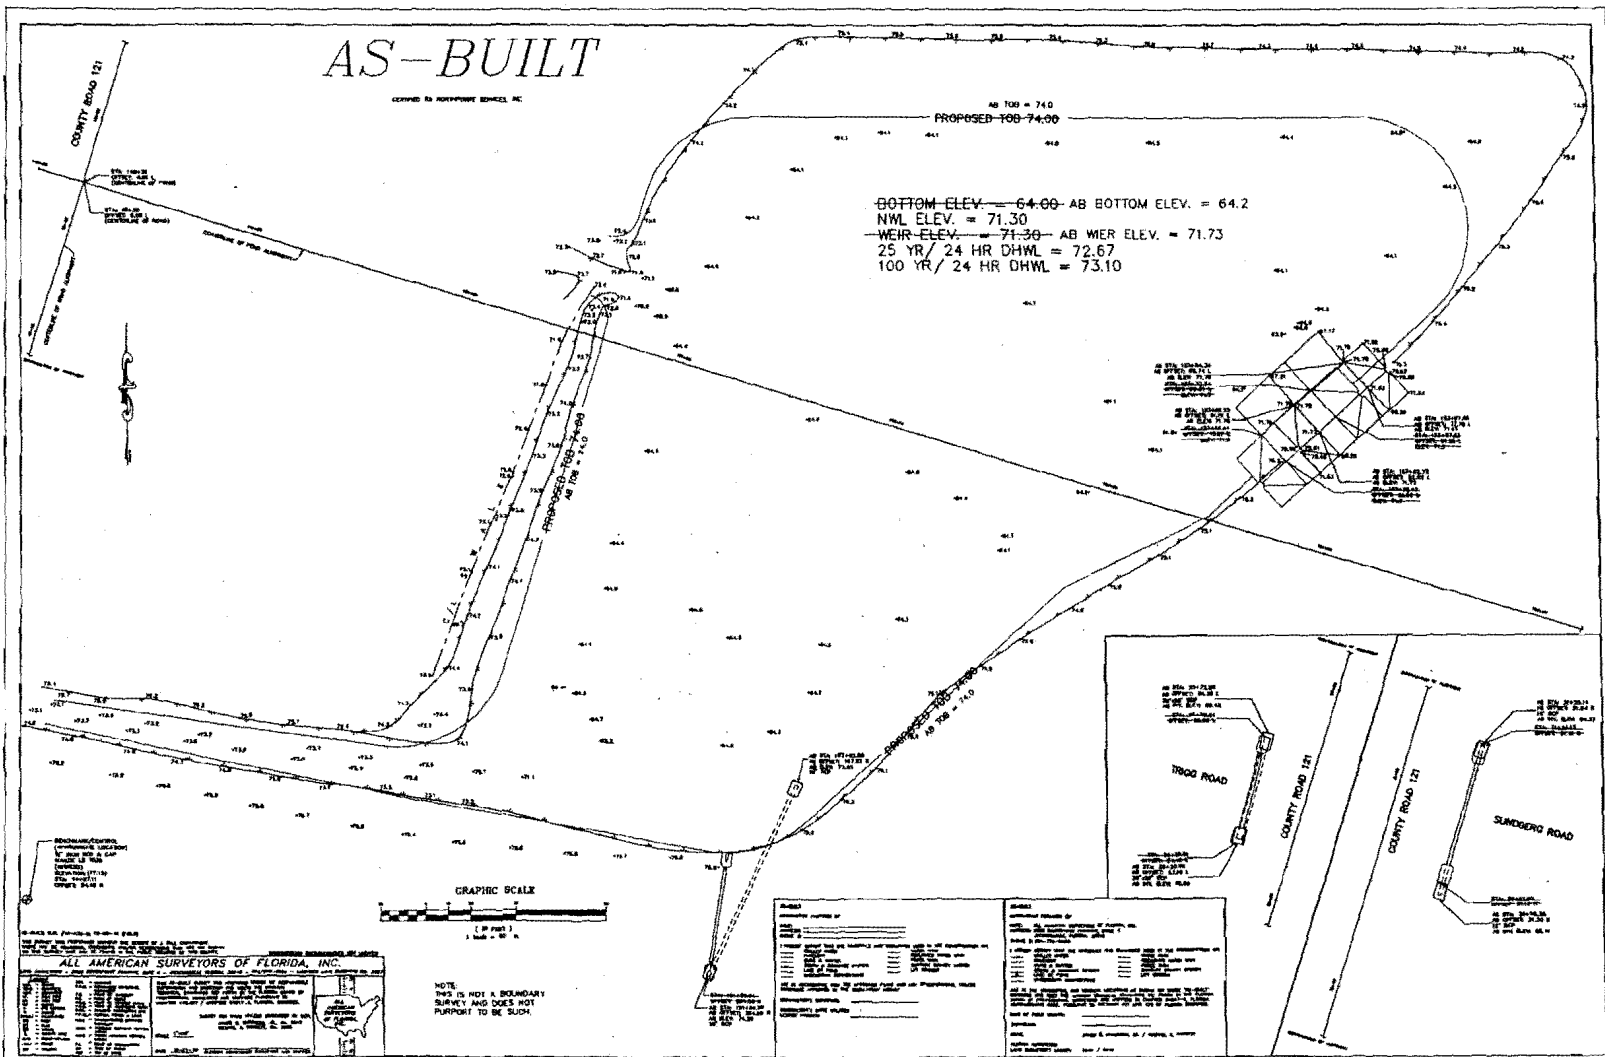
- 104-13-1 --> Did not utilize all of bid quantity.
120-1A --> Overrun necessary due to pond reconfiguration and necessity to maintain original drainage patterns.
530-3-4 --> Overrun necessary due to plan quantity error and addition of RipRap at MES treatment to eliminate erosion potentials.
570-1-2, Sod -> Overrun necessary due to pond reconfiguration and necessity to stabilize pond banks.
570-1-2 S&M -> Overrun necessary due to pond reconfiguration and necessity to stabilize pond banks.
ProPex --> Overrun necessary due to pond reconfiguration and necessity to stabilize pond banks.
Re-Mobe --> Addition necessary due to RipRap plan quantity error.

By: 
Carrie Smithheart, ETM

Date: 12/28/10

AS-BUILT

CONVISED BY HOFFMAN ENGINEERS, INC.



ALL AMERICAN SURVEYORS OF FLORIDA, INC.

10000 W. US Highway 1, Suite 100, Jacksonville, Florida 32217
Phone: 904-751-1111
Fax: 904-751-1112
www.aasurveyors.com

REGISTERED PROFESSIONAL SURVEYORS
STATE OF FLORIDA
No. 12345
Exp. 12/31/2025

PROJECT: [Project Name]
DATE: [Date]
SCALE: [Scale]

BY: [Surveyor Name]
CHECKED BY: [Surveyor Name]

NO.	DESCRIPTION	DATE
1	AS-BUILT SURVEY	10/15/2024
2	PROPOSED SURVEY	08/20/2024
3	EXISTING SURVEY	05/10/2024

