



Florida Power & Light Company

LUMP SUM RELOCATION AGREEMENT

Applicant Nassau County Board of County Commissioners agrees to pay FPL the lump sum amount of \$116,422.59 to relocate FPL poles at Flounder Gig & Miner Rd.

Applicant understands that this cost is valid for 180 days from the date of this agreement and is based on the Applicant's plans which are dated 01/23/25. Applicant understands that this agreement is solely for the relocation of FPL facilities. It is the Applicant's responsibility to contact the owners of facilities co-located on FPL's poles (such as telephone, cable and wireless/cell phone providers), and to negotiate, and pay the cost of, the relocation of such facilities. Applicant understands that FPL's work under this agreement cannot proceed until such third party negotiations have been completed. Applicant shall provide FPL with written documentation from each such third party provider reflecting the date upon which such third party facilities will be relocated. Applicant also agrees that any scope of work changes listed below will result in FPL providing a revised Lump Sum cost which Applicant is obligated to pay.

These scope changes are:

1. Change in Applicant's plans/schedule which will affect FPL's relocation.
2. Any error in Applicant's plans which will affect FPL's relocation.

Applicant agrees to pay FPL in advance the full Lump Sum amount for this relocation. This Lump Sum amount is non-refundable, provided, however if this agreement is terminated or indefinitely suspended, the Applicant shall be responsible for the costs actually incurred by FPL and any additional cost incurred by FPL to restore FPL's facilities to complete operational capability and FPL shall refund the balance.

Applicant acknowledges that high voltage electric lines are located in the area of Applicant's project and agrees to warn its employees, agents, contractors and invitees, new and experienced alike, of the danger of holding on to or touching a cable or other piece of equipment that is located or working close to any overhead power line and to use all safety and precautionary measures when working under or near FPL's facilities. Applicant acknowledges and agrees that it has read and will comply with the Notification of FPL Facilities attached hereto.

Limitations of Liability. Neither Party shall be liable in contract, in tort (including negligence), or otherwise to the other Party for any incidental or consequential loss or damage whatsoever including but not limited to loss of profits or revenue on work not performed, for loss of use or under utilization of the Party's facilities, or loss of use of revenues or loss of anticipated profits resulting from either Party's performance, nonperformance, or delay in performance of its obligations under this Agreement.

Indemnification. The Applicant shall indemnify, defend and hold harmless FPL, its parent, subsidiaries or affiliates and their respective officers, directors and employees (collectively "FPL Entities") from and against any liabilities whatsoever, occasioned wholly or in part by the negligence of the Applicant, its contractors, subcontractors or employees, including attorney fees, for injury to or death of person(s) and property damage arising or resulting in connection with any activity associated with work or service under this Agreement, **EXCEPT** if the liability arises out of a claim made by an employee of the Applicant, its contractors or assigns, the Applicant shall indemnify FPL Entities whether or not the damage or liability is due to or caused by the sole negligence of FPL Entities. The Applicant's obligation to protect, defend and hold FPL Entities free and unharmed against such liabilities shall be subject to the limitation set forth in Section 768.28(5) Florida Statutes, except in the event the Applicant purchases insurance covering the liability with limits in excess of the statutory limits, the Applicant's obligation shall extend up to but shall not exceed the limits of that insurance.

Insurance. If the Applicant utilizes its own personnel in the construction or maintenance work around the subject Facilities, the Applicant shall furnish FPL with evidence of insurance maintained by Applicant insuring FPL Entities from liabilities assumed under the above indemnification. Said insurance shall contain a broad form contractual endorsement or, alternatively, the Applicant shall cause FPL, its parent, subsidiaries and affiliates and their respective officers, directors and employees to be named as additional named insured on the



Florida Power & Light Company

Applicant's comprehensive general liability policy. Such liability coverage shall be primary to any liability coverage maintained by or on behalf of FPL up to the \$1,000,000 limit of liability.

In the event that the policy is on a "claims made" basis, the retroactive date of the policy shall be the effective date of this or such other date as to protect the interest of FPL and the coverage shall survive the termination of this Agreement until expiration of the maximum statutory period of limitations in the State of Florida for actions based in contract or in tort (currently, five years). If coverage is an "occurrence" basis, such insurance shall be maintained by the Applicant during the entire term of this Agreement. The policy shall not be canceled or materially altered without at least thirty (30) days written notice to FPL.

The Applicant shall provide FPL with evidence of such liability insurance coverage and the standard insurance industry form (ACORD) without modification. A copy of the policy shall be made available for inspection by FPL upon reasonable request.

Contractor Indemnification. The Applicant further agrees to include the following indemnification in all contracts between the Applicant and its general contractors who perform or are responsible for construction or maintenance work on or around the subject FPL Facilities:

"The Contractor hereby agrees to release, indemnify, defend, save and hold harmless the Applicant and FPL, its parent, subsidiaries, affiliates or their respective officers, directors, or employees, from all claims, demands, liabilities and suits whether or not due to or caused by negligence of the Applicant or FPL for bodily injuries or death to person(s) or damage to property resulting in connection with the performance of the described work by Contractor, its subcontractor, agents or employees. This indemnification shall extend up to but shall not exceed the sum of \$1,000,000.00 for bodily injury or death of person(s) or property damage combined single limit and \$3,000,000.00 occurrence aggregate. In the event the Contractor is insured for liability with limits in excess of these amounts, Contractor's said obligation shall extend up to but shall not exceed the limits of that insurance. Contractor's costs of defending Applicant and FPL, including attorneys' fees are excluded from and are in addition to the aforesaid limitation of liability for injury, death and property damage."

Contractor Insurance and Notice. The Applicant agrees to require its contractors to obtain insurance to cover the above indemnity and further agrees to verify with its contractors that such insurance is in full force and effect. The Applicant shall provide FPL Group Inc.'s Risk Management Department with notice of the name and address of Applicant's contractors prior to the commencement of the Relocation of FPL Facilities by FPL.

This agreement may be terminated at any time upon written agreement between Applicant and FPL.

FLORIDA POWER & LIGHT COMPANY:

By: Michael Spruiell

Print Name: Michael Spruiell

Title: Associate Engineer

Date: 01/23/25

APPLICANT:

By: [Signature]



Print Name: A.M. "Trey" Harriman

Title: Chairman

Date: March 24, 2025

FEEDERS: YULEE 01463

☐ INACCESSIBLE ☐ 13KV ☐ FUTURE 23KV ☒ 23KV ☐ SALT SPRAY ☐ ROCK

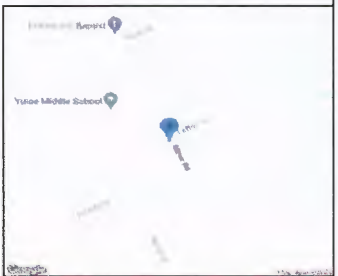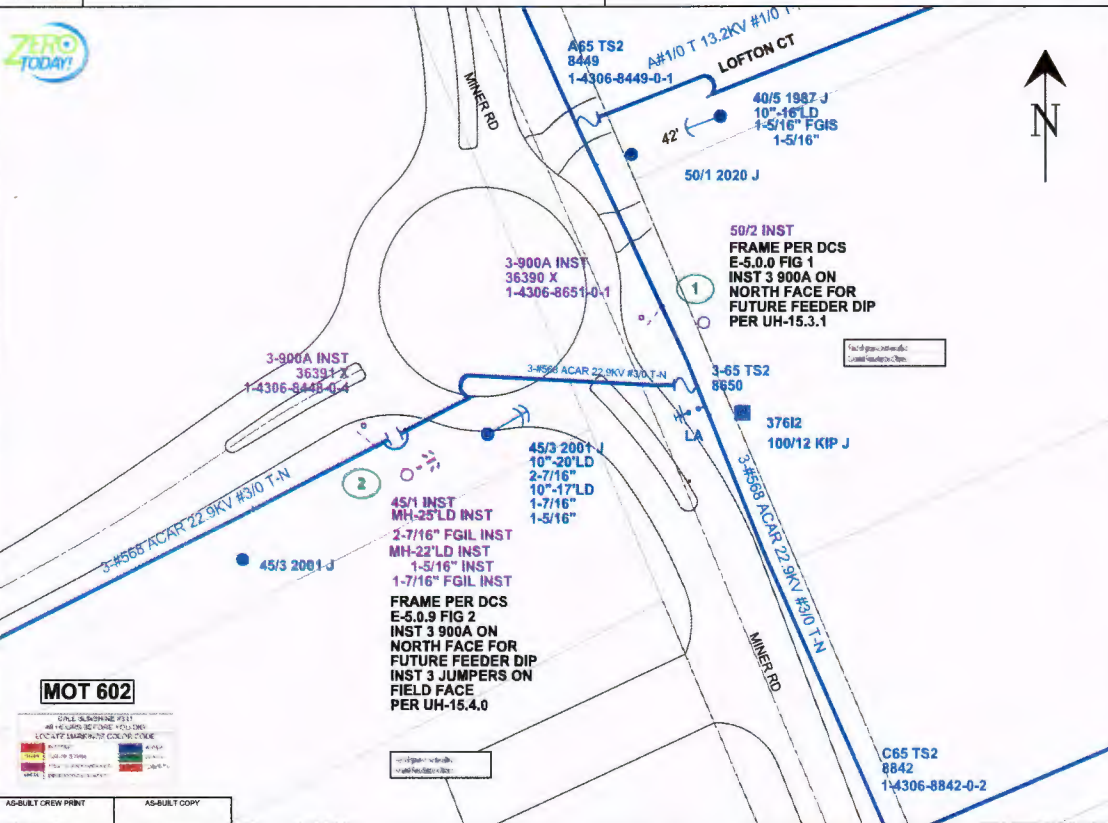


PLEASE BE ADVISED THAT RECEIPT OF THIS DRAWING AND/OR SURVEY, WHICH IS AN APPROXIMATION, DOES NOT RELIEVE YOU OF ANY STATUTORY OBLIGATIONS, INCLUDING THE PROVISIONS CONTAINED IN SECTION 556, FLORIDA STATUTES. CALL 811 (Sunshine811) PRIOR TO ANY EXCAVATION ACTIVITIES.

COPYRIGHT 2014 FPL ALL RIGHTS RESERVED
- THE MATERIAL CONTAINED HEREIN MAY CONTAIN INACCURACIES. THERE ARE NO EXPRESSED OR IMPLIED WARRANTIES. THE USER IS WARNED TO UTILIZE AT HIS/HER OWN RISK. USER ASSUMES RISK OF ANY AND ALL LOSS.

CONSTRUCTION NOTES:
LOC 1: INST POLE AND SWITCHES
LOC 2: INST POLE, SWITCHES, GUYS, AND ANCHORS
- FRAMING IS BASED ON THE POWER SYSTEMS DISTRIBUTION CONSTRUCTION STANDARDS (DCS MANUAL).
- ALL POLES TO BE SET PER DCS D-3.0.0 UNLESS NOTED OTHERWISE.
- SET POLES WITH BRANDING FACING THE STREET WHENEVER POSSIBLE.
- INSTALL TLM TAGS AS INDICATED ON DRAWING.
- TAG FUSE SIZE ON POLE AS INDICATED ON DRAWING.
- CHECK VOLTAGE ROTATION AND CONTINUITY AT EACH TRANSFORMER AND RISER LOCATION.

MOT 602

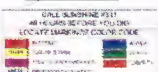

AS-BUILT CROW PRINT AS-BUILT COPY

Foreman's Signature _____ Date _____
Supervisor's Signature _____ Date _____
All required ground rods have been driven & verified to be within FPL standards. Values are shown at all locations.
Foreman's Signature _____ Date _____

Design? <input type="checkbox"/>	Tree Work? <input type="checkbox"/>	Tree Access? <input type="checkbox"/>	Tree Staking Req? <input type="checkbox"/>
Design/State? <input type="checkbox"/>	CT/Special Mt? <input type="checkbox"/>	Work with SMO? <input type="checkbox"/>	Survey/State? <input type="checkbox"/>
POLE LINE FT.	POLE LINE FT. ON TRANS. POLES	TRENCH FT.	DUCT BANK FT.
PERMIT REQD	CITY <input type="checkbox"/>	COUNTY RD <input type="checkbox"/>	COUNTY AIR <input type="checkbox"/>
	WMO <input type="checkbox"/>	RR KING <input type="checkbox"/>	DR. DIST. <input type="checkbox"/>
Requested Tel. Co. Set Poles? <input type="checkbox"/>	Requested Tel. Co. Trencher? <input type="checkbox"/>	Requested CATV Transfer? <input type="checkbox"/>	



Job Owner: Joshua Koon	M/A: NF	Township: 02 Range: 27 Section 38
Designer: Joshua Koon	Date: 04/29/2022	75BLS - 85439 MINER RD - MAKE READY POLE AND INLINE DIP POLE
Scale: 1" = 40'	85439 MINER RD, YULEE, 32097	
0' 40' 80'	Dwg No. 10988362_11x17.xml	Map No. GG1225
	WR: 10988362	Page 1 of 1

Size: 11 x 17


PRINTED BY: jdkdyo

PLOT DATE/TIME: 04/29/2022 08:48:37

Cover Sheet: WR#11408392

Page 1 of 2

[] INACCESSIBLE [] 13KV [] FUTURE 23KV [] 23KV [] SALT SPRAY [] ROCK

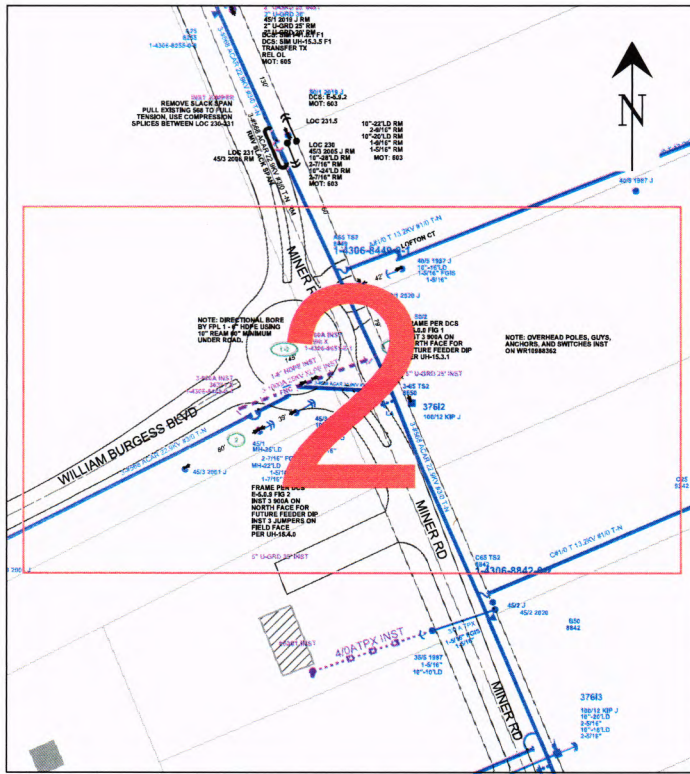

COPYRIGHT 2014 FPL ALL RIGHTS RESERVED

- THE MATERIAL CONTAINED HEREIN MAY CONTAIN INACCURACIES. THERE ARE NO EXPRESSED OR IMPLIED WARRANTIES.
- THE USER IS WARNED TO UTILIZE AT HIS/HER OWN RISK. USER ASSUMES RISK OF ANY AND ALL LOSS.

CAUTION

- THIS DRAWING IS MERELY AN APPROXIMATION. EXACT LOCATION OF FPL COMPANY UNDERGROUND FACILITIES MUST BE DETERMINED PRIOR TO ANY SUBSURFACE OPERATIONS IN THIS AREA.
- ALL BOUNDARIES ARE APPROXIMATE. ONLY ACCURATE ON THE DAY OF THIS TRANSMISSION. FACILITY LOCATION AND DEPTH SUBJECT TO CHANGE WITHOUT NOTICE. NOT TO BE USED FOR SURVEY OR EXCAVATION PURPOSES.

NOTE: THE LOCATION AND EXISTENCE OF ANY FACILITIES MAY NOT BE RELIED UPON BY THE SUPPLIER IN RESPONDING TO A BID OR IN COMPLYING WITH ANY CONTRACT. SUPPLIER IS RESPONSIBLE FOR EVALUATING SITE CONDITIONS BOTH ABOVE AND BELOW GROUND INCLUDING UNDERGROUND FACILITY LOCATIONS.

PLEASE BE ADVISED THAT RECEIPT OF THIS DRAWING AND/OR SURVEY, WHICH IS AN APPROXIMATION, DOES NOT RELIEVE YOU OF ANY STATUTORY OBLIGATIONS INCLUDING THE PROVISIONS CONTAINED IN SECTION 556, FLORIDA STATUTES.
CALL 811 (Sunshine811) PRIOR TO ANY EXCAVATION ACTIVITIES

CALL SUNSHINE 811 48 HOURS BEFORE YOU DIG LOCATE MARKINGS COLOR CODE

RED	ELECTRIC	BLUE	WATER
YELLOW	GAS-ONE STEAM	GREEN	SEWER
PINK	TEMP. SURVEY MARKINGS	ORANGE	CABLE TV
WHITE	PROPOSED EXCAVATION		

American Disabilities Act

If pole placement location does not meet the minimum single point distance of 32" from edge of curb or back of sidewalk, contact your Production Lead, for further instructions.



Friendship Baptist

Yulee Middle School

CONSTRUCTION NOTES:

REQUIRED DRAWINGS:

- TRENCH:
- CENTERLINE OF TRENCH IS 5 FT OUTSIDE R/W EASEMENT;
 - 10 FEET FRONT, 5 FEET SIDE, 8 FEET REAR
 - MAINTAIN A MINIMUM OF 12" SEPERATION FROM ALL OTHER UTILITIES
 - INSTALL #12C WIRE ALONGSIDE EMPTY COUNTOUR RUNS
 - EXTEND PVC 10FT FROM TX FOR FUTURE SERVICES
 - CUSTOMER INSTALLED CONDUIT: ALL
 - CABLE:
 - 1PN1C IS 1CC #10/0A 25KV-XLPE IN 1-2" PVC WITH 36" MIN COVER
 - SECONDARY IS #4/0 TPX HM-HD IN 1-2" PVC WITH 24" MIN COVER (UNLESS NOTED)
 - ALL CABLE AND/OR CONDUIT ENDS ARE TO BE MARKED WITH AN ELECTRONIC MARKER
 - (XXX) DENOTES CABLE PULL DISTANCE
 - UNDERGROUND OBSTRUCTIONS ARE TO BE LOCATED PRIOR TO DIGGING
 - INSTALL NEUTRAL BOND FOR COMMUNICATION COMPANIES AT ALL SINGLE PHASE TRANSFORMERS PER D.C.S. G-11.0.0
 - ALL HANDHOLES ARE 24" (UNLESS NOTED)
 - ALL TRANSFORMERS ARE LOW STYLE (UNLESS NOTED)
 - EXTEND SERVICE PVC 10 R INTO CUSTOMER PROPERTY FUSING
 - FUSE ALL PHASES AT 50K
 - STREET LIGHTS:
 - STREET LIGHTS ARE 9500L HPSV TRADITIONAL ON 20 FT FIBERGLASS POLES - FPL OWNED AND MAINTAINED



Easement? []	Tree Work? []	Tree Access? []	Tree Staking Req'd? []
Designer/State? []	CT/Special Mkt? []	Work with DM? []	Survey/State? []
POLE LINE FT. ON TRANSM. POLES:	TRENCH FT.	DUCT BANK FT.	
PERMIT REQ'D	CITY []	COUNTY RD []	COUNTY AIR []
	WMD []	RR XING []	DR. DIST. []
Requested Tel. Co. Set Poles? []	Requested Tel. Co. Transfer? []	Request CATV Transfer? []	



Job Owner:	Joshua Keown	M/A: NF	Township: 02 Range: 27 Section 38
Designer:	Joshua Keown	75BLS - 85439 MINER RD - DIRECTIONAL BORE	
Date:	06/27/2022		
Scale: 1" = 88'	85439 MINER RD, YULEE, 32097		
0'	88'	177'	Dwg No. 11408392_11x17 UG.xml
			Map No. GG1225
			WR: 11408392
			Page 1 of 2

Sub: 11 x 17


PRINTED BY: JAOYD

PLOT DATE/TIME: 06/27/2022 15:02:38

REVISION
1
2
3
4

FEEDERS: YULEE 01463

[] INACCESSIBLE [] 13KV [] FUTURE 23KV [X] 23KV [] SALT SPRAY [] ROCK

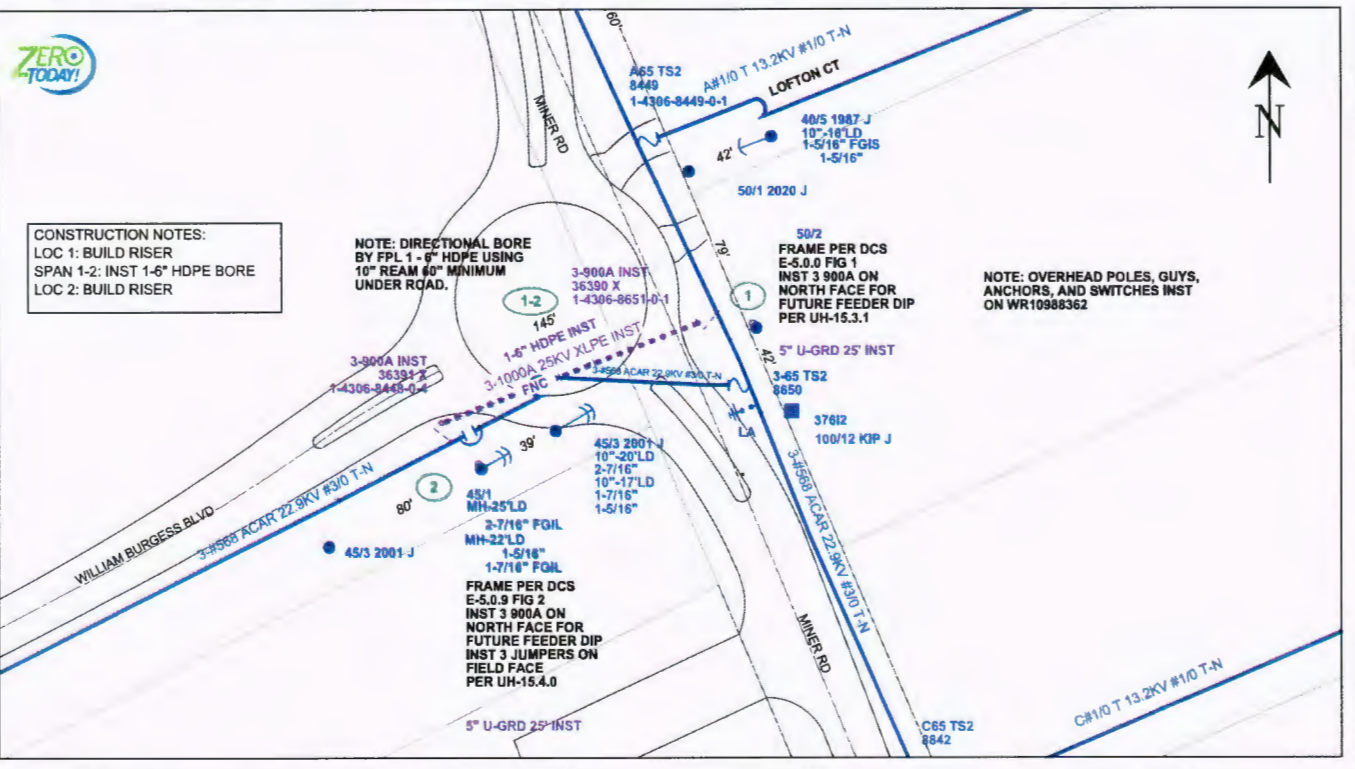

CONSTRUCTION NOTES:
LOC 1: BUILD RISER
SPAN 1-2: INST 1-6\"/>

NOTE: DIRECTIONAL BORE
BY FPL 1-6\"/>

NOTE: OVERHEAD POLES, GUYS,
ANCHORS, AND SWITCHES INST
ON WR10988362

REVISION

Sheet 11 x 17

PRINTED BY: JMOYO

DATE

IPC

PLOT DATE/TIME: 06/27/2022 15:02:38

AS-BUILT CREW PRINT		AS-BUILT COPY	
Foreman's Signature	Date	Initiate	Cart. Date
Job CERTIFIED COMPLETED as shown on this AS-BUILT print. Material changes shown on RGS.			
Supervisor's Signature	Date		
All required ground rods have been checked & verified to be within FPL standards. Values are shown at all locations.			
Foreman's Signature	Date		


Equipment []	Tree Work []	Tree Access []	Tree Staking Req'd []
Design/State? []	CT/Special MP? []	Work with SMD? []	Survey/State? []
POLE LINE FT. ON TRANSM. POLES:	TRENCH FT.	DUCT BANK FT.	
CITY []	COUNTY RD []	COUNTY AIR []	STATE RD []
PERMIT REQ'D	WMD []	R/R XING []	DR. DIST. []
Requester Tel. Co. Set Probe? []	Requester Tel. Co. Transfer? []	Request CATV Transfer? []	



Job Owner:	Joshua Kacem	M/A: NF	Township: 02 Range: 27 Section: 38
Designer:	Joshua Kacem	758LS - 85439 MINER RD - DIRECTIONAL BORE	
Date:	06/27/2022		
Scale: 1" = 43'			
0'	43'	86'	
Dwg No. 11408392_11x17 UG.xml		Map No. GG1225	
WR: 11408382		Page 2 of 2	

FEEDERS: YULEE 01463

[] INACCESSIBLE [] 13KV [] FUTURE 23KV [X] 23KV [] SALT SPRAY [] ROCK

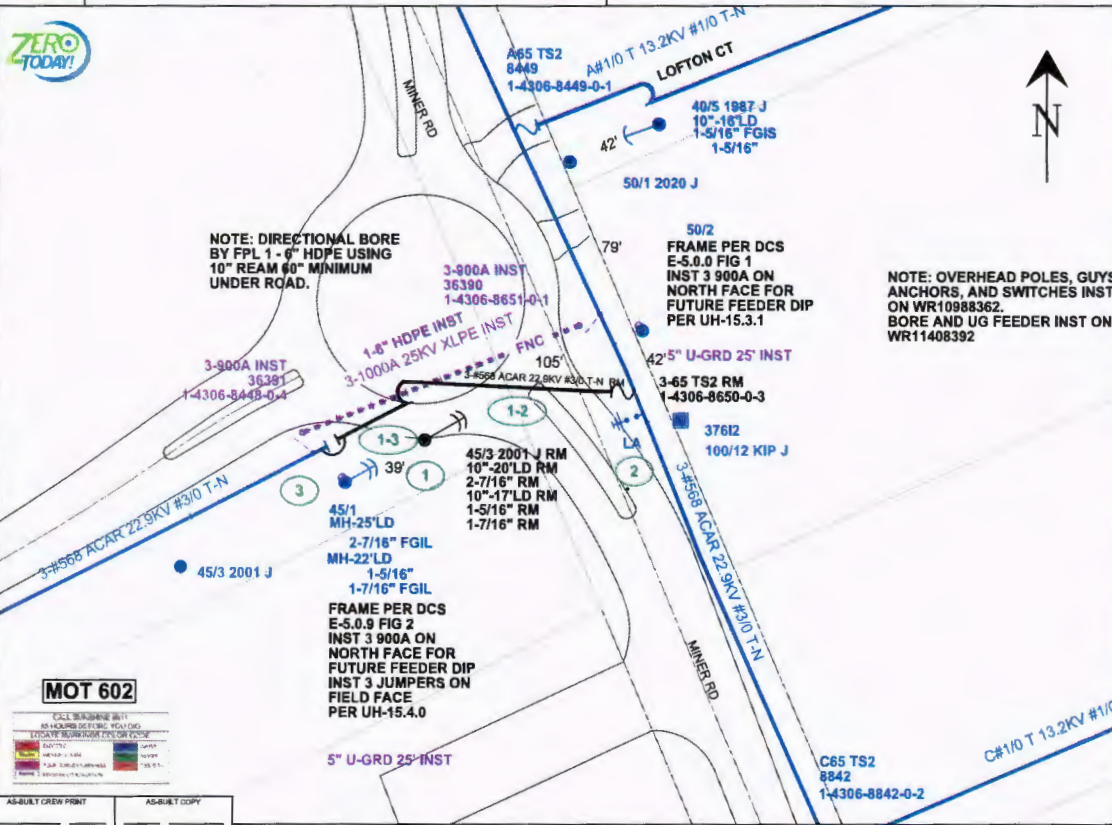

PLEASE BE ADVISED THAT RECEIPT OF THIS DRAWING AND/OR SURVEY WHICH IS AN APPROXIMATION, DOES NOT RELIEVE YOU OF ANY STATUTORY OBLIGATIONS, INCLUDING THE PROVISIONS CONTAINED IN SECTION 556, FLORIDA STATUTES. CALL 811 (Sunshine811) PRIOR TO ANY EXCAVATION ACTIVITIES.

COPYRIGHT 2014 FPL ALL RIGHTS RESERVED
- THE MATERIAL CONTAINED HEREIN MAY CONTAIN INACCURACIES. THERE ARE NO EXPRESSED OR IMPLIED WARRANTIES. THE USER IS WARNED TO UTILIZE AT HIS/HER OWN RISK. USER ASSUMES RISK OF ANY AND ALL LOSS.

CONSTRUCTION NOTES:
LOC 1: REMOVE POLE, GUYS, AND ANCHORS
SPAN 1-2: REMOVE PRIMARY SLACK SPAN
LOC 2: REMOVE ALS AND FRAMING
SPAN 1-3: REMOVE PRIMARY
LOC 3: REMOVE JUMPERS AND FRAMING
- FRAMING IS BASED ON THE POWER SYSTEMS DISTRIBUTION CONSTRUCTION STANDARDS (DCS MANUAL).
- ALL POLES TO BE SET PER DCS D-3.0.0 UNLESS NOTED OTHERWISE.
- SET POLES WITH BRANDING FACING THE STREET WHENEVER POSSIBLE.
- INSTALL TLM TAGS AS INDICATED ON DRAWING.
- TAG FUSE SIZE ON POLE AS INDICATED ON DRAWING.
- CHECK VOLTAGE ROTATION AND CONTINUITY AT EACH TRANSFORMER AND RISER LOCATION.

MOT 602

CALL NUMBER	1-4306-8449-0-1
AS-BUILT	1-4306-8449-0-1
DATE	04/29/2022
BY	JAC
CHECKED	JAC
DATE	04/29/2022

AS-BUILT CREW PRINT	AS-BUILT COPY
Foreman's Signature _____ Date _____ Initials _____ Cont. Date _____	

Job CERTIFIED COMPLETED as shown on this AS-BUILT print. Material changes shown on ROD.

Supervisor's Signature _____ Date _____

All required ground rods have been driven & verified to be within FPL standards. Values are shown at all locations.

Foreman's Signature _____ Date _____

Customer? []	Tree Work? []	Tree Access? []	Tree Staking Req'd? []
Designer/State? []	CTD/Special Mt? []	Work with SMD? []	Survey/State? []
Pole Line FT. []	Pole Line FT. on Transm. Poles []	Trench FT. []	Duct Bank FT. []
PERMIT REQD	CITY [] COUNTY RD [] COUNTY AIR [] STATE RD [] FAA []	WMAD [] RR YONG [] DR. DIST. [] TRANSRA []	
Requested Tel. Co. Set Poles? []	Requested Tel. Co. Transfer? []	Request CATV Transfer? []	



Job Owner: Joshua Keown	M/A: NF	Township: 02 Range: 27 Section 38
Designer: Joshua Keown	Date: 04/29/2022	75BLS - 85439 MINER RD - REMOVE EXISTING OVERHEAD
Scale: 1" = 40'	85439 MINER RD, YULEE, 32097	
Dwg No. 11408394_11x17.xml	Map No. G61225	
WR: 11408394	Page 1 of 1	

Size: 11 x 17
PRINTED BY: JAC090

PLOT DATE/TIME: 04/29/2022 14:13:03

Cover Sheet: WR#11435128

Page 1 of 3

☐ INACCESSIBLE


☐ 13KV

☐ FUTURE 23KV

☒ 23KV

☐ SALT SPRAY

☐ ROCK

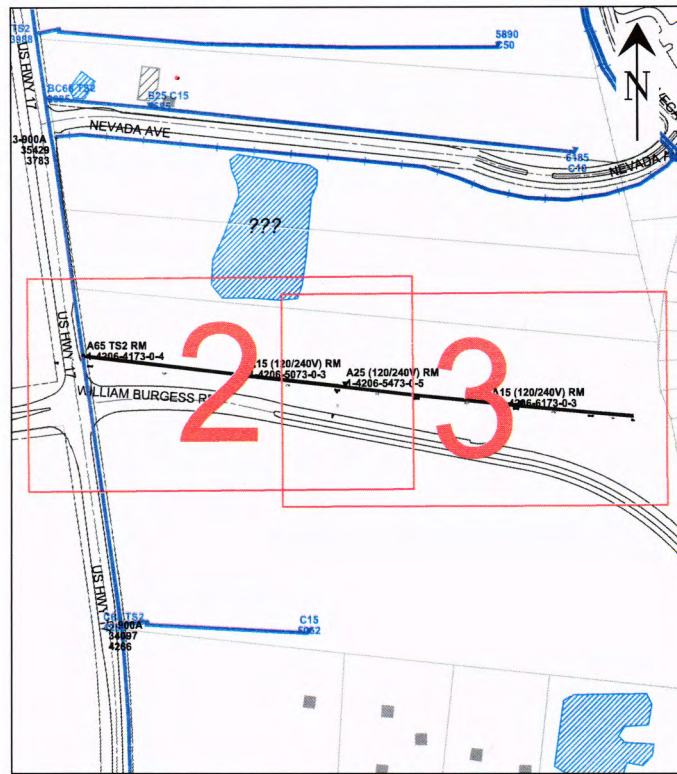

GENERAL NOTES


- NOTIFY CUSTOMERS OF TEMPORARY POWER AND TRAFFIC INTERRUPTIONS.
- PROVIDE WARNING SIGNALS FOR PEDESTRIANS AND TRAFFIC SIGNALS FOR MOTORISTS.
- SERVICE TO TRAFFIC SIGNAL, SCHOOL FLASHING SIGNAL, AND LIGHT STATIONS MUST REMAIN ENERGIZED AT ALL TIMES.

STAKING NOTES-INTERMEDIATE POLES: STAKE POLES IN-LINE AT STATED DISTANCES.
-POLE REPLACEMENT: STAKE POLES IN-LINE AND WITHIN 2' OF EITHER SIDE OF EXISTING POLE UNLESS OTHERWISE NOTED.
-ALL POLES STAKED WITH FIELD SIDE FACE AT R/W LINE UNLESS OTHERWISE NOTED.
-SEE BELOW FOR ADDITIONAL DETAILED STAKING NOTES.

GENERAL GROUNDING, GUYING, AND U-GUARD NOTES

- BOND WIRE (DCS D-2.0.0, FIG. 1-3 AND D-7.0.0, DETAIL A AND B)
- ATTACH BOND WIRE TO THE GUY WIRE AND DO NOT ATTACH TO PREFORMED GRIP.
- STREET LIGHT BRACKETS (DCS H-11.0.0, FIG. 1-4 AND DCS H-11.1.0, FIG. 1-5)
- GROUND ALL STREET LIGHT BRACKETS (I.E. TO POLE BOND IF GROUND RODS ARE REQUIRED OR TO SYSTEM NEUTRAL IF NO GROUND RODS ARE REQUIRED.
- U-GUARDS (DCS UH-14.0.0 AND UH-14.0.2)
- WOOD POLES: USE TAPCON FASTENERS IN ALL BASE SECTION HOLES AND EVERY OTHER HOLE OF TOP SECTIONS.
- CONCRETE POLES: USE AT LEAST 10 TAPCON FASTENERS PER 10 FOOT U-GUARD SECTION AND AT LEAST 6 TAPCON FASTENERS FOR SHORTER SECTIONS.
- BACK PLATE (DCS UH-14.0.1)
- REQUIRED ON FIRST 10 FOOT SECTION ABOVE GROUND (WOOD AND CONCRETE POLES).
- GUYING (DCS D-2.0.0)
- GUYS SHALL HAVE A GUY MARKER (GUY GUARD) INSTALLED AT ALL LOCATIONS.
- RISER (DCS G-10.1.0 AND G-10.2.0)
- BOND ALL METAL RISER CONDUITS ON POLES.
- GROUND RODS (DCS G-3.0.1)
- TOP MUST BE A MINIMUM OF 6 INCHES BELOW GRADE.

CALL SUNSHINE #811 48 HOURS BEFORE YOU DIG LOCATE MARKINGS COLOR CODE			
RED	ELECTRIC	BLUE	WATER
YELLOW	GAS OIL STE-A&J	GREEN	SEWER
PINK	TEMP. SURVEY MARKINGS	ORANGE	CABLE TV
WHITE	PROPOSED EXCAVATION		

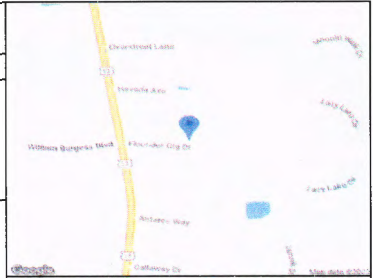

PLEASE BE ADVISED THAT RECEIPT OF THIS DRAWING AND/OR SURVEY, WHICH IS AN APPROXIMATION, DOES NOT RELIEVE YOU OF ANY STATUTORY OBLIGATIONS, INCLUDING THE PROVISIONS CONTAINED IN SECTION 558, FLORIDA STATUTES. CALL 811 (Sunshine811) PRIOR TO ANY EXCAVATION ACTIVITIES

CONSTRUCTION NOTES:

- FRAMING IS BASED ON THE POWER SYSTEMS DISTRIBUTION CONSTRUCTION STANDARDS (DCS MANUAL).
- ALL POLES TO BE SET PER DCS D-3.0.0 UNLESS NOTED OTHERWISE.
- SET POLES WITH BRANDING FACING THE STREET WHENEVER POSSIBLE.
- INSTALL TLM TAGS AS INDICATED ON DRAWING.
- TAG FUSE SIZE ON POLE AS INDICATED ON DRAWING.
- CHECK VOLTAGE ROTATION AND CONTINUITY AT EACH TRANSFORMER AND RISER LOCATION.

American Disabilities Act

If pole placement location does not meet the minimum single point distance of 32" from edge of curb or back of sidewalk, contact your Production Lead, for further instructions.



Easement? <input type="checkbox"/>	Tree Work? <input type="checkbox"/>	Tree Access? <input type="checkbox"/>	Tree Staking Req'd? <input type="checkbox"/>
Designer/State? <input type="checkbox"/>	CT/Special Mkt? <input type="checkbox"/>	Work with SMO? <input type="checkbox"/>	Survey/State? <input type="checkbox"/>
POLE LINE FT. ON TRANS. POLES:	TRENCH FT.:	DUCT BANK FT.:	
PERMIT REQ'D:	CITY <input type="checkbox"/>	COUNTY RD <input type="checkbox"/>	COUNTY AIR <input type="checkbox"/>
WMD <input type="checkbox"/>	RR XING <input type="checkbox"/>	DR. DIST. <input type="checkbox"/>	TRANS. <input type="checkbox"/>
Requested Tel. Co. Set Poles? <input type="checkbox"/>	Requested Tel. Co. Transfer? <input type="checkbox"/>	Request CATV Transfer? <input type="checkbox"/>	



Job Owner:	Joshua Kacem	M/A: NF	Township: 02 Range: 27 Section 42
Designer:	Joshua Kacem	75BLS - 86087 FLOUNDER GIG DR - REMOVE 125' OH LATERAL	
Date:	06/26/2022		
Scale 1" = 210'		86097 FLOUNDER GIG DR, YULEE, 32097	
0'	210'	419'	
		Dwg No. 11435128_11x17 OH.xml	Map No. GJ1228
		WR: 11435128	Page 1 of 3

REVISED


PRINTED BY: jdkay0

PLOT DATE/TIME: 06/29/2022 11:21:16

DATE

IPC	DATE
1	
2	
3	
4	

 ☐ INACCESSIBLE ☐ 13KV ☐ FUTURE 23KV ☒ 23KV ☐ SALT SPRAY ☐ ROCK




CALL SUNSHINE 8311
45 MINUTES BEFORE YOU GO!
UPGRADE MARKINGS ON THE ROAD

NEW	CLIPPING	NEW	OPTION
TRUCK	TRUCK	TRUCK	TRUCK
TRUCK	TRUCK	TRUCK	TRUCK
TRUCK	TRUCK	TRUCK	TRUCK
TRUCK	TRUCK	TRUCK	TRUCK

PLOT DATE/TIME: 06/29/2022 11:27:27 IPC: 1 2 3 4	AS-BUILT CREW POINT		AS-BUILT COPY	
	Foreman's Signature _____	Date _____	Inside _____	Cert. Date _____
	ARE CERTIFIED COMPLETED as shown on this AS-BUILT print. Material changes shown on PCS.			
	Supervisor's Signature _____	Date _____		
All required ground rods have been driven & verified to be within FPL standards. Values are shown at all locations.				
Foreman's Signature _____		Date _____		

Easement? []		Tree Work? []		Tree Access? []		Tree Spacing Req'd? []	
Designated State? []		CT/Special Met? []		Work with SWS? []		Survey/State? []	
POLE LINE FT. []		POLE LINE FT. ON TRANSFORM. POLES: []		TRENCH FT. []		DUCT BANK FT. []	
CITY [] COUNTY RD [] COUNTY AIR []		STATE RD []		FAA []			
PMSMT/RECD [] RR/IND [] DR. DIST. []		TRIANG. []					
Requester Tel. Co. See PMSMT? []		Requester Tel. Co. Transfer? []		Requester CATV Transfer? []			



Job Owner: Joshua Keown		M/A: NF		Township: 02 Range: 27 Section 42	
Designer: Joshua Keown		06/29/2022		75BLS - 86097 FLOUNDER GIG DR - REMOVE 1250' OH LATERAL	
Date: 06/29/2022		Scale: 1" = 50'		86097 FLOUNDER GIG DR, YULEE, 32097	
0'		60'		120'	
Dwg No. 11435128_11x17 OH.xml		Map No. GJ1228			
WR: 11435128				Page 2 of 3	

[] INACCESSIBLE


[] 13KV

[] FUTURE 23KV

[X] 23KV

[] SALT SPRAY

[] ROCK

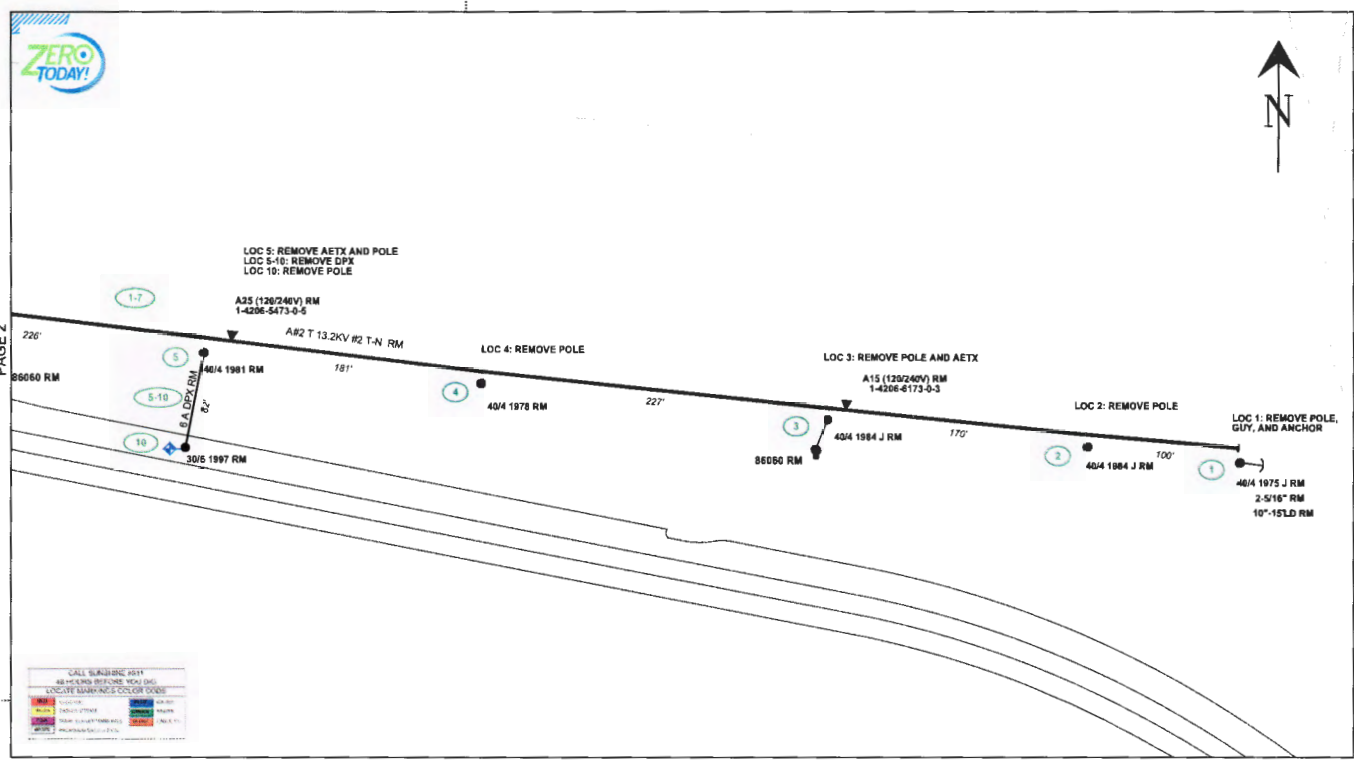

PRINTED BY: jk0vy0

PLOT DATE/TIME: 06/29/2022 11:27:37

AS-BUILT CHW PRINT		AS-BUILT COPY	
Foreman's Signature	Date	Initials	Cart. Date
Job CERTIFIED COMPLETED as shown on this AS-BUILT 1 print. Material changes shown on RDS.			
Estimate# []		Year Work# []	Year Access# []
Designer/State# []		City/Specall Mkt# []	Survey/State# []
Supervisor's signature		Date	
All required permits from this table must be located & included to be within FPL standards. Values are shown at all locations.			
Foreman's Signature	Date		
Requested Tel. Co. Sol. Order# []		Requested Tel. Co. Transfer# []	
Request CATV Transfer# []			
Job Owner:		Joshua Kroom	
Designer:		Joshua Kroom	
Date:		06/29/2022	
Scale: 1" = 60'		86097 FLOUNDER GIG DR, YULEE, 32097	
0'		60'	
120'		Dwg No. 11435128_11x17 OH.xml	
		WR: 11435128	
		Map No. GJ1225	
		Page 3 of 3	