

SECTION 00 63 63

CHANGE ORDER REQUEST FORM

PROJECT William Burgess Extension

No. 005

DATE OF ISSUANCE 07/10/2025

EFFECTIVE DATE 07/10/2025

NASSAU COUNTY BOARD OF COUNTY COMMISSIONERS

COUNTY Contract No.: CM 3707

CONTRACTOR- Petticoat Schmitt Civil Contractors Inc ENGINEER / ARCHITECT- Ron Hoogland / GAI

Description of changes:

Refer to the following attachment for description: Change Order No. 005.

Plan Revision No. 02 reconfigured the drainage system leading into Pond D. The revision redirects water directly from structures S-75, S-76, S-78, S-80, and S-81 to the MES within the pond. This change eliminated a deep pipe run and resulted in cost savings for the County

Attachments: (List documents supporting change) Engineers Estimate; EOR's Quantity Changes; Email concurrence

CHANGE IN CONTRACT PRICE:

Original Contract Price

\$ 16,451,809.10

CHANGE IN CONTRACT TIMES:

Original Contract Times

Substantial Completion: 505 days (06/2/2026)
(days and dates)Ready for Final Payment: 550 days (07/17/26)
(days and dates)

Net change from previous Change Orders No. 1 to No. 4

\$ 54,450.59

Net change from previous Change Orders No. 1 to No. 4

0

(days)

Contract Price prior to this Change Order

\$ 16,506,259.69

Contract Times Prior to This Change Order

Substantial Completion: 505 days (06/2/2026)
(days and dates)Ready for Final Payment: 550 days (07/17/2026)
(days and dates)

Net Increase (decrease) of this Change Order

\$ -121,043.47

Net Increase (decrease) of this Change Order

0

(days)

Contract Price with all approved Change Orders

\$ 16,385,216.22

Contract Times with all approved Change Orders

Substantial Completion: 505 days (06/2/2026)
(days and dates)Ready for Final Payment: 550 days (07/17/2026)
(days and dates)

RECOMMENDED:

By: Ron Hoogland
Engineer/Architect (Authorized Signature)

Date: 7/23/2025

APPROVED:

By: Raymond Allure
COUNTY (Authorized Signature)

Date: 7/23/2025

ACCEPTED:

By: Jeff Rumer
Contractor (Authorized Signature)

Date: 8/15/2025

CHANGE ORDER APPROVAL FORM

PROJECT: William Burgess Extension

CHANGE ORDER NUMBER: 005

DATE: 08/15/2025

CONTRACT NUMBER: CM3707

PURCHASE ORDER NUMBER (IF APPLICABLE): 240000614

TO CONTRACTOR: Petticoat-Schmitt Civil Contractors

Description:
This project includes the extension of William Burgess Boulevard (WBB) from US17 to Miner Road. The roadway extension is an urban typical section that primarily includes two traffic lanes, curb and gutter, sidewalks, a shared use path (SUP), and landscaping. There is roadway widening and resurfacing required to tie-in US17, the west approach to WBB and the east connect to Miner Road. The intersection improvements include US 17, a roundabout at Theresa Court and a roundabout at Miner Road. Infrastructure improvements include drainage conveyance, stormwater pond facilities, new JEA utilities (16" watermain and 16" dry sanitary force main), street lighting, signalization, irrigation, and utility relocations/protections

Reason for Change Order:
Plan Revision No. 02 reconfigured the drainage system leading into Pond D. The revision redirects water directly from structures S-75, S-76, S-78, S-80, and S-81 to the MES within the pond. This change eliminated a deep pipe run and resulted in cost savings for the County

Original Contract Sum.....	\$ <u>16,451,809.10</u>
Net Change by Previous Change Order/Supplemental Agreement.	\$ <u>54,450.59</u>
Contract Sum Prior to This Change Order.....	\$ <u>16,506,259.69</u>
Amount of this Change Order (Deduct).....	\$ <u>-121,043.47</u>
New Contract Sum Including this Change Order.....	\$ <u>16,385,216.22</u>

The Contract Time will be **increased or decreased (select one)** N/A 0 days
Previous Substantial Completion: 06/02/2026 Previous Final Completion: 07/17/2026
New Substantial Completion: 06/02/2026 New Final Completion: 07/17/2026


APPROVED BY: <u>Robert Companion</u>	DATE: <u>8/18/2025</u>
Department Head/Managing Agent	
APPROVED BY: <u>Janice Holmes</u>	DATE: <u>8/19/2025</u>
Procurement	

APPROVED BY: Chris Lacambra
Office of Management and Budget

DATE: 8/18/2025 

APPROVED BY: Denise C. May, Esq., BCS
County Attorney

DATE: 8/28/2025 

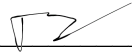APPROVED BY: 
County Manager

DATE: 8/29/2025

APPROVED BY: N/A
Chairman

DATE: _____

ATTEST: N/A
Mitch L. Keiter, Clerk of Courts

DATE: _____

Account No(s). 63470541-563100 WBEXT

CHANGE ORDER No. 05 - ESTIMATED COSTS - REV02 Quantity Changes

Material Costs						
Deductions						
Pay Item	Description	Qty	Unit	Cost		
400-174-130	Pipe Culvert Round 30"	-220	LF	\$ 225.47	\$	(49,603.40)
400-174-124	Pipe Culvert Round 24"	-490	LF	\$ 198.60	\$	(97,314.00)
430-982-133	Mitered End Section 30"	-1	Ea	\$ 8,519.64	\$	(8,519.64)
425-1-351	Inlet Type P-5(>10)	-1	Ea	\$ 21,654.89	\$	(21,654.89)
425-1-412	Inlet Type J-1(>10)	-1	Ea	\$ 17,386.71	\$	(17,386.71)
425-1-312	Inlet Type P-1 (>10)	-2	Ea	\$ 13,353.08	\$	(26,706.16)
				Total	\$	(221,184.80)
Additions						
430-174-118	Pipe Culvert Round 18"	142	LF	\$ 146.38	\$	20,785.96
430-174-115	Pipe Culvert Round 15"	85	LF	\$ 186.37	\$	15,841.45
430-982-123	Mitered End Section 15"	2	Ea	\$ 2,873.91	\$	5,747.82
425-1-311	Inlet Type P-1 (<10)	4	Ea	\$ 10,588.71	\$	42,354.84
530-3-4	Rubble Rip Rap	17	SY	\$ 314.14	\$	5,340.38
Provided Cost	Mitered End Section 18"	3	Ea	\$ 3,356.96	\$	10,070.88
				Total	\$	100,141.33

Grand Total	\$	(121,043.47)
--------------------	-----------	---------------------

Jeremy J
Cronk

Digitally signed by Jeremy J
Cronk
Date: 2025.07.11 09:12:47
-04'00'

REVISED BID FORM – NC24-010-ITB ADDENDUM 3

	A	ROADWAY				
Item No.	Spec No.	Item	Estimated Qty.	Unit	Unit Cost	Total
1	101 1	MOBILIZATION	1	LS	\$ 850,933.14	\$ 850,933.14
2	102 1	MAINTENANCE OF TRAFFIC (MOT)	1	LS	\$ 166,158.69	\$ 166,158.69
3	102-3	COMMERICAL MATERIAL	100	SY	\$ 80.73	\$ 8,073.00
4	102 71 13	TEMPORARY BARRIER, F&I LOW PROFILE	2120	LF	\$ 73.82	\$ 156,498.40
5	102 71 16	TEMPORARY BARRIER, F&I FREESTANDING	1630	LF	\$ 45.52	\$ 74,197.60
6	102 71 23	TEMPORARY BARRIER, RELOCATE, LOW PROFILE	1740	LF	\$ 26.98	\$ 46,910.40
7	102 71 26	TEMPORARY BARRIER, RELOCATE, FREESTANDING	1370	LF	\$ 22.84	\$ 31,290.80
8	102 89 1	TEMPORARY CRASH CUSHION, REDIRECTIVE OPTION	8	EA	\$ 2,058.69	\$ 16,469.52
9	102 99	PORTABLE CHANGEABLE MESSAGE SIGN, TEMPORARY	600	ED	\$ 18.01	\$ 10,806.00
10	104 1	EROSION CONTROLS	1	LS	\$ 263,111.97	\$ 263,111.97
11	107-2	MOWING	170	AC	\$ 193.01	\$ 32,811.70
12	110 1 1	CLEARING & GRUBBING (INCLUDES TREE CLEARING)	1	LS	\$ 718,800.37	\$ 718,800.37
13	110 4 10	REMOVAL OF EXISTING CONCRETE	827	SY	\$ 24.42	\$ 20,195.34
14	120 1	REGULAR EXCAVATION	43,425	CY	\$ 7.71	\$ 334,806.75
15	120 4	SUBSOIL EXCAVATION	7,767	CY	\$ 27.59	\$ 214,291.53
16	120 4A	OVER EXCAVATION (CONTINGENCY)	1	LS	\$ 50,000.00	\$ 50,000.00
17	120 6	EMBANKMENT	70,648	CY	\$ 12.42	\$ 877,448.16
18	120 6A	A-3 SAND BACKFILL (CONTINGENCY)	1	LS	\$ 50,000.00	\$ 50,000.00
19	160 4	TYPE B STABILIZATION (12")	60,476	SY	\$ 11.34	\$ 685,797.84
20	285 7 01	OPTIONAL BASE, BASE GROUP 01, (4") Type B 12.5	685	SY	\$ 48.70	\$ 33,359.50
21	285 7 04	OPTIONAL BASE, BASE GROUP 04	11,762	SY	\$ 19.88	\$ 233,828.56
22	285 7 09	OPTIONAL BASE, BASE GROUP 9, 10" LIMEROCK	37,017	SY	\$ 29.74	\$ 1,100,885.58
23	0327 70 4	MILLING EXIST ASPH PAVT, 3" AVG DEPTH	5310	SY	\$ 6.55	\$ 34,780.50
24	0327 70 6	MILLING EXIST ASPH PAVT, 1 1/2" AVG DEPTH	4811	SY	\$ 4.23	\$ 20,350.53
25	0334 1 13	SUPERPAVE ASPHALTIC CONC, TRAFFIC C (SHARED USE PATH)	971	TN	\$ 172.31	\$ 167,313.01
26	0334 1 53	SUPERPAVE ASPHALTIC CONCRETE, TRAFFIC C, PG 76-22 (ROADWAY)	3,774	TN	\$ 252.11	\$ 951,463.14
27	0337 7 83	ASPHALT CONCRETE FRICTION COURSE, TRAFFIC C, FC-12.5, PG 76-22	3,970	TN	\$ 266.12	\$ 1,056,496.40
28	0339 1	MISCELLANEOUS ASPHALT PAVEMENT	2	TN	\$ 673.52	\$ 1,347.04
29	400 11	CONCRETE CLASS NS, GRAVITY WALL	39	CY	\$ 3,085.81	\$ 120,346.59
30	0520 1 7	CONCRETE CURB & GUTTER, TYPE E	367	LF	\$ 41.39	\$ 15,190.13
31	520 1 10	CONCRETE CURB & GUTTER, TYPE F	18,845	LF	\$ 34.59	\$ 651,848.55
32	520 1 10 A	CONCRETE CURB & GUTTER, TYPE "1.5' WIDE CITY"	8930	LF	\$ 27.46	\$ 245,217.80
33	520 2 4	CONCRETE CURB & GUTTER, TYPE D	2979	LF	\$ 29.96	\$ 89,250.84
34	520 2 8	CONCRETE CURB & GUTTER, TYPE RA	547	LF	\$ 35.32	\$ 19,320.04
35	520 3	VALLEY GUTTER CONCRETE	358	LF	\$ 48.18	\$ 17,248.44
36	520 5 41	TRAFFIC SEPARATOR, CONCRETE, TYPE I (OPTION 1)	150	SY	\$ 109.52	\$ 16,428.00
37	520 5 41	TRAFFIC SEPARATOR, CONCRETE, TYPE IV, 4' WIDE	293	LF	\$ 46.02	\$ 13,483.86
38	522 1	SIDEWALK CONCRETE & DRIVEWAYS 4" THICK	6605	SY	\$ 68.15	\$ 450,130.75
39	522 2	SIDEWALK CONCRETE & DRIVEWAYS 6" THICK	1690	SY	\$ 92.54	\$ 156,392.60
40	522 2A	SIDEWALK CONCRETE & DRIVEWAYS 7" THICK	95	SY	\$ 135.95	\$ 12,915.25
41	527 1	DETECTABLE WARNINGS	672	SF	\$ 41.80	\$ 28,089.60
42	530 3 4	RUBBLE RIP RAP	28.8	SY	\$ 314.14	\$ 9,047.23
43	0550 10220	FENCING, TYPE B, 5.1- 6.0', STANDARD	3,907	LF	\$ 36.93	\$ 144,285.51
44	0550 60235	FENCE GATE, TYPE B, DOUBLE, 24.1- 30.0' OPENING	5	EA	\$ 4,825.05	\$ 24,125.25
45	0570 1 2	PERFORMANCE TURF (SOD)	68,638	SY	\$ 2.90	\$ 199,050.20

+ 17 SY

REVISED BID FORM – NC24-010-ITB ADDENDUM 3

SUBTOTAL: A - ROADWAY						\$ 10,420,796.11
B		DRAINAGE				
Item No.	Item	Estimated Qty.	Unit	Unit Cost	Total	
46	425 1311	41	EA	\$ 10,588.71	\$	434,137.11
47	425 1312	2	EA	\$ 13,353.08	\$	26,706.16
48	425 1321	12	EA	\$ 11,043.13	\$	132,517.56
49	425 1351	15	EA	\$ 9,490.57	\$	142,358.55
50	425 1351	1	EA	\$ 21,654.89	\$	21,654.89
51	425 1361	3	EA	\$ 14,463.73	\$	43,391.19
52	425 1411	6	EA	\$ 16,012.86	\$	96,077.16
53	425 1412	4	EA	\$ 17,386.71	\$	69,546.84
54	425 1421	2	EA	\$ 16,709.56	\$	33,419.12
55	425 1351	3	EA	\$ 4,821.23	\$	14,463.69
56	425 1543	2	EA	\$ 7,659.44	\$	15,318.88
57	425 1548	1	EA	\$ 10,122.86	\$	10,122.86
58	425 1910	2	EA	\$ 6,492.84	\$	12,985.68
59	425 2 41	4	EA	\$ 7,637.96	\$	30,551.84
60	425 2 61	4	EA	\$ 7,637.96	\$	30,551.84
61	425 2 71	3	EA	\$ 10,455.73	\$	31,367.19
62	425 2 91	1	EA	\$ 14,338.87	\$	14,338.87
63	425 2 92	1	EA	\$ 13,652.54	\$	13,652.54
64	430174115	555	LF	\$ 186.37	\$	103,435.35
65	430174118	4,760	LF	\$ 146.38	\$	696,768.80
66	430174124	1,921	LF	\$ 198.60	\$	381,510.60
67	430174130	1,414	LF	\$ 225.47	\$	318,814.58
68	430174136	1,094	LF	\$ 285.07	\$	311,866.58
69	430174136	889	LF	\$ 346.77	\$	308,278.53
70	430175218	190	LF	\$ 184.51	\$	35,056.90
71	430518100	1	EA	\$ 4,114.91	\$	4,114.91
72	430982123	6	EA	\$ 2,873.91	\$	17,243.46
73	430982129	3	EA	\$ 3,840.01	\$	11,520.03
74	430982133	7	EA	\$ 8,519.64	\$	59,637.48
75	430982138	2	EA	\$ 10,449.13	\$	20,898.26
76	430982140	1	EA	\$ 14,935.78	\$	14,935.78
SUBTOTAL: B - DRAINAGE						\$ 3,457,243.23
C		SIGNING AND PAVEMENT MARKING				
Item No.	Item	Estimated Qty.	Unit	Unit Cost	Total	
77	654 2 11	2	AS	\$ 11,670.19	\$	23,340.38
78	700 1 11	68	AS	\$ 501.81	\$	34,123.08
79	700 1 60	13	AS	\$ 38.60	\$	501.80
80	700 12 21	2	AS	\$ 12,541.27	\$	25,082.54
81	706 1 3	949	EA	\$ 9.35	\$	8,873.15
82	710 17	156	SF	\$ 2.67	\$	416.52
83	710 11101	5,837	GM	\$ 2,401.95	\$	14,020.18

+4 EA.
-2 EA.

-1 EA.

-1 EA.

+85'

+142'

-490'

-220'

+2 EA.

-1 EA.

From: [Ron Hoogland](#)
To: [Jeremy Cronk](#)
Cc: [Joe Kainer](#); [Patty Ellington](#); [Kent Ponder](#)
Subject: RE: William Burgess Extension - Plan REV02 Quantities
Date: Thursday, June 26, 2025 1:16:24 PM
Attachments: [image001.png](#)
[REV02 Quantity Changes Rev rh.pdf](#)

See attached.

rh

From: Jeremy Cronk <CronkJ@etminc.com>
Sent: Friday, June 13, 2025 10:59 AM
To: Ron Hoogland <r.hoogland@gaiconsultants.com>
Cc: Joe Kainer <KainerJ@etminc.com>; Patty Ellington <EllingtonP@etminc.com>; Kent Ponder <PonderK@etminc.com>
Subject: RE: William Burgess Extension - Plan REV02 Quantities

EXERCISE CAUTION: This is an External Email Message!

Think before clicking on links, opening attachments, or responding

Ron,

Attached are the quantity changes for revision 2 that I have come with. I missed two 18" MES in the below breakdown. Please confirm these quantities are accurate.

Thanks,

Jeremy Cronk Project Administrator
CronkJ@etminc.com | cell: 904.497.3236
[England-Thims & Miller, Inc.](#) | [Career Opportunities](#)

From: Jeremy Cronk
Sent: Wednesday, June 11, 2025 12:01 PM
To: Ron Hoogland (r.hoogland@gaiconsultants.com) <r.hoogland@gaiconsultants.com>
Cc: Joe Kainer <KainerJ@etminc.com>; Patty Ellington <EllingtonP@etminc.com>; Kent Ponder <PonderK@etminc.com>
Subject: RE: William Burgess Extension - Plan REV02 Quantities

Ron,



Any update on this? I believe I have everything else covered, but I'm still waiting on the Rip

Engineer of Record Confirmed Quantities

Material Costs						
Deductions						
Pay Item	Description	Qty	Unit	Cost		
400-174-130	Pipe Culvert Round 30" 220	-229	LF	\$ 225.47	\$	(51,632.63)
400-174-124	Pipe Culvert Round 24" 490	-490	LF	\$ 198.60	\$	(97,314.00)
430-982-133	Mitered End Section 30"	-1	Ea	\$ 8,519.64	\$	(8,519.64)
425-1-351	Inlet Type P-5(>10)	-1	Ea	\$ 21,654.89	\$	(21,654.89)
425-1-412	Inlet Type J-1(>10)	-1	Ea	\$ 17,386.71	\$	(17,386.71)
425-1-312	Inlet Type P-1 (>10)	-2	Ea	\$ 13,353.08	\$	(26,706.16)
				Total	\$	(223,214.03)
Additions						
430-174-118	Pipe Culvert Round 18"	142	LF	\$ 146.38	\$	20,785.96
430-174-115	Pipe Culvert Round 15"	85	LF	\$ 186.37	\$	15,841.45
430-982-123	Mitered End Section 15"	2	Ea	\$ 2,873.91	\$	5,747.82
425-1-311	Inlet Type P-1 (<10)	3 4	Ea	\$ 10,588.71	\$	31,766.13
425-1-411	Inlet Type J-1 (<10)	1	Ea	\$ 16,012.86	\$	16,012.86
530-3-4	Rubble Rip Rap	17	SY	\$ 314.14	\$	5,340.38
Contractor Provided Cost	Mitered End Section 18"	3	Ea	\$ 3,356.96	\$	10,070.88
				Total	\$	105,565.48

Grand Total	\$	(117,648.55)
--------------------	-----------	---------------------

Engineer of Record Confirmed Quantities

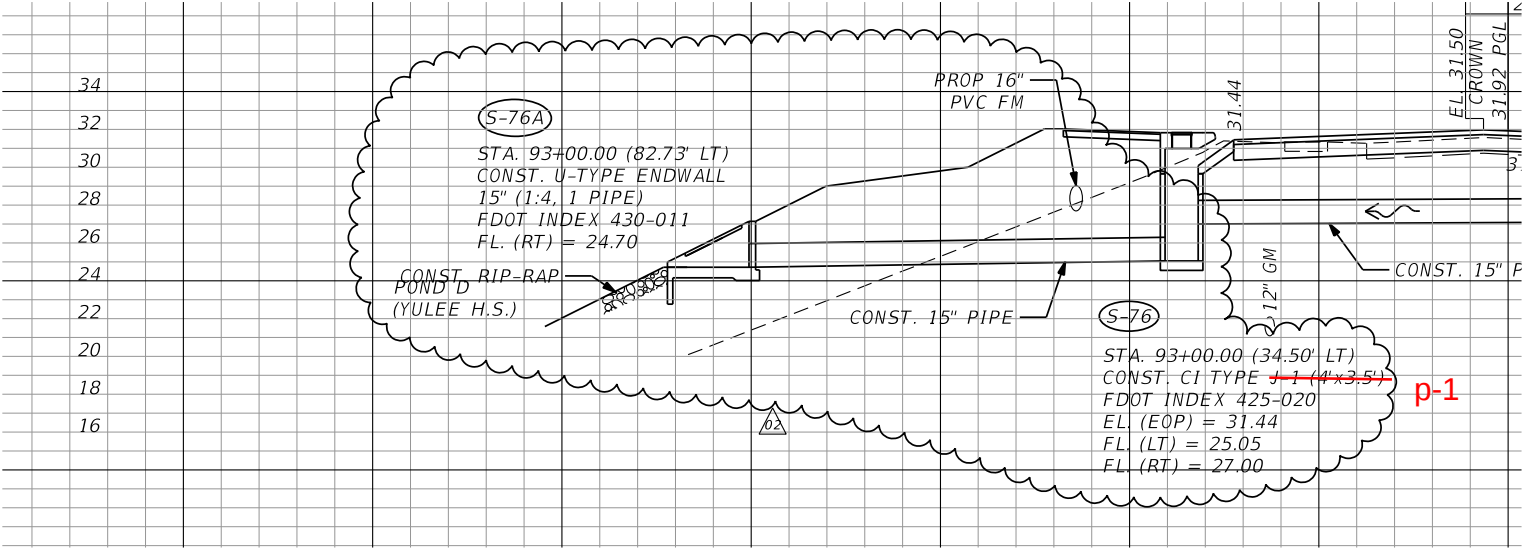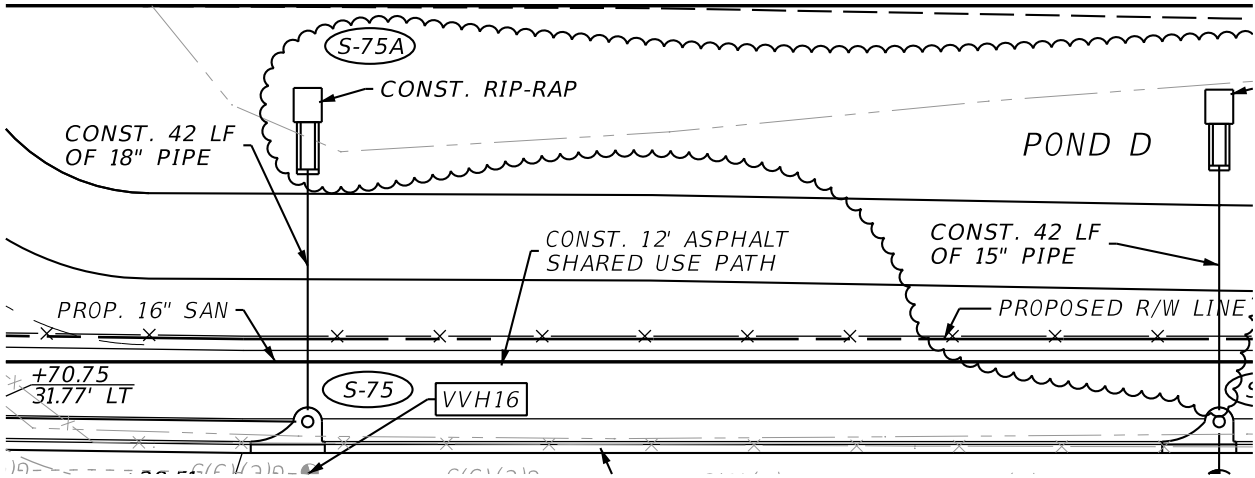

Jeremy Cronk

From: Daniel Siciliano <dsiciliano@petticoatschmitt.com>
Sent: Wednesday, July 9, 2025 5:12 PM
To: Jeremy Cronk
Cc: Kent Ponder; Joe Kainer; Patty Ellington; John Patterson
Subject: Re: William Burgess Extension - Change Order No. 05 - Plan Revision 2 Quantity Changes

Subject: Re: Quantity Changes for Plan Revision No. 02

Hi Jeremy,

Thanks for sending this over. I've reviewed the quantity changes and appreciated you are sharing them ahead of the formal submission to Nassau County. Everything looks good on my end so far, and I understand all work related to this revision will be covered under the upcoming change order.

I'll let you know if any questions come up as we move forward.

Thanks again,
Daniel



Daniel Siciliano
project manager

phone 904.751.0888
cell 727.698.8550
email dsiciliano@petticoatschmitt.com
website www.petticoatschmitt.com
address 8014 Bayberry Rd.
Jacksonville, FL 32256

[Ask us about ELEVATE20](#)

Please note: We've moved to a new address!
Please make sure to update your records.

From: Jeremy Cronk <CronkJ@etminc.com>
Sent: Wednesday, July 9, 2025 12:54 PM
To: Daniel Siciliano <dsiciliano@petticoatschmitt.com>
Cc: Kent Ponder <PonderK@etminc.com>; Joe Kainer <KainerJ@etminc.com>; Patty Ellington <EllingtonP@etminc.com>; John Patterson <jpatterson@petticoatschmitt.com>
Subject: William Burgess Extension - Change Order No. 05 - Plan Revision 2 Quantity Changes

[EXTERNAL]

Daniel,

As discussed in the progress meeting yesterday, attached is the quantity changes for plan revision No. 02. The EOR has verified these quantities but I wanted to share with you prior to sending the change order to Nassau County. All work associated with this revision will be paid for with this change order. Let us know if you have any questions.

Thanks,



Jeremy Cronk Project Administrator

CronkJ@etminc.com | cell: 904.497.3236 |

etminc.com | Career Opportunities

CAUTION: This email originated from outside of ETM. Do not click links or open attachments unless you recognize the sender and know the content is safe.

Jeremy Cronk

From: Parker Thorlakson <pthorlakson@petticoatschmitt.com>
Sent: Tuesday, May 20, 2025 1:13 PM
To: Jeremy Cronk
Cc: Joe Kainer; John Benton
Subject: Re: William Burgess - Plan Rev02

Jeremy,

For an 18" MES you're looking at approximately \$3,356.96.

Thanks,



Parker Thorlakson
project engineer

phone 904.751.0888
cell 904.802.2446
email pthorlakson@petticoatschmitt.com
website www.petticoatschmitt.com
address 8014 Bayberry Rd. Jacksonville,
FL 32256

[Ask us about ELEVATE20](#)

Please note: We've moved to a new address!
Please make sure to update your records.

From: Jeremy Cronk <CronkJ@etminc.com>
Sent: Tuesday, May 20, 2025 12:05 PM
To: John Benton <jbenton@petticoatschmitt.com>
Cc: Joe Kainer <KainerJ@etminc.com>; Parker Thorlakson <pthorlakson@petticoatschmitt.com>
Subject: William Burgess - Plan Rev02

[EXTERNAL]

John,

Plan revision 02 revised the drainage into pond D. We have established pricing for all items with the exception of the 18" MES. Could you please provide a price for a 18" MSE?



Jeremy Cronk Project Administrator

CronkJ@etminc.com | cell: 904-497-3236 |
etminc.com | Career Opportunities

CAUTION: This email originated from outside of ETM. Do not click links or open attachments unless you recognize the sender and know the content is safe.

NASSAU COUNTY ENGINEERING

CONTRACT PLANS



WILLIAM BURGESS BLVD. EXTENSION

CONTRACT PLANS COMPONENTS

- ROADWAY PLANS
- SIGNING AND PAVEMENT MARKING PLANS
- SIGNALIZATION PLANS
- LIGHTING PLANS
- LANDSCAPING PLANS
- JEA WATER/SEWER PLANS

INDEX OF ROADWAY PLANS

SHEET NO.	SHEET DESCRIPTION
1	KEY SHEET
2 - 2b	SIGNATURE SHEET
3 - 5	DRAINAGE MAP
6 - 13	TYPICAL SECTION
14 - 17	SUMMARY OF DRAINAGE STRUCTURES
18	OPTIONAL MATERIALS TABULATION
19 - 21	PROJECT LAYOUT
22 - 23	CURVE & COORDINATE DATA
24 - 25	GENERAL NOTES
26 - 51	ROADWAY PLAN-PROFILE
52 - 53	INTERSECTION DETAIL
54 - 59	CONSTRUCTION DETAILS
60 - 94	DRAINAGE STRUCTURES
95 - 99	RETENTION/DETENTION PONDS
100	CROSS SECTION PATTERN
101	POND SOIL SURVEY
102	ROADWAY SOIL SURVEY
103 - 209	ROADWAY CROSS SECTIONS
210	SUMMARY OF VERIFIED UTILITIES
211 - 212	EROSION CONTROL
213	STORMWATER POLLUTION PREVENTION PLAN
214 - 233	TEMPORARY TRAFFIC CONTROL PLAN
W-1 - W-6	WETLAND IMPACT PLAN

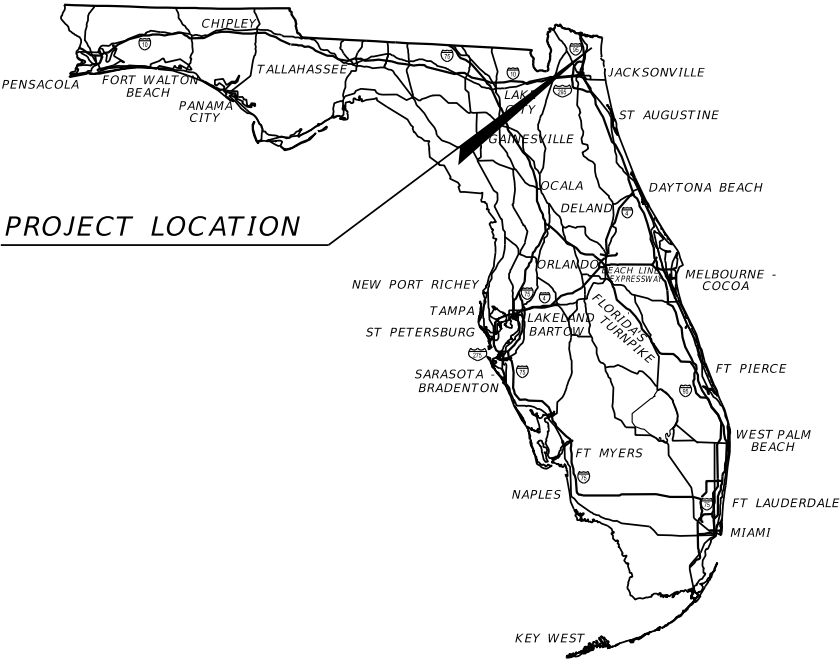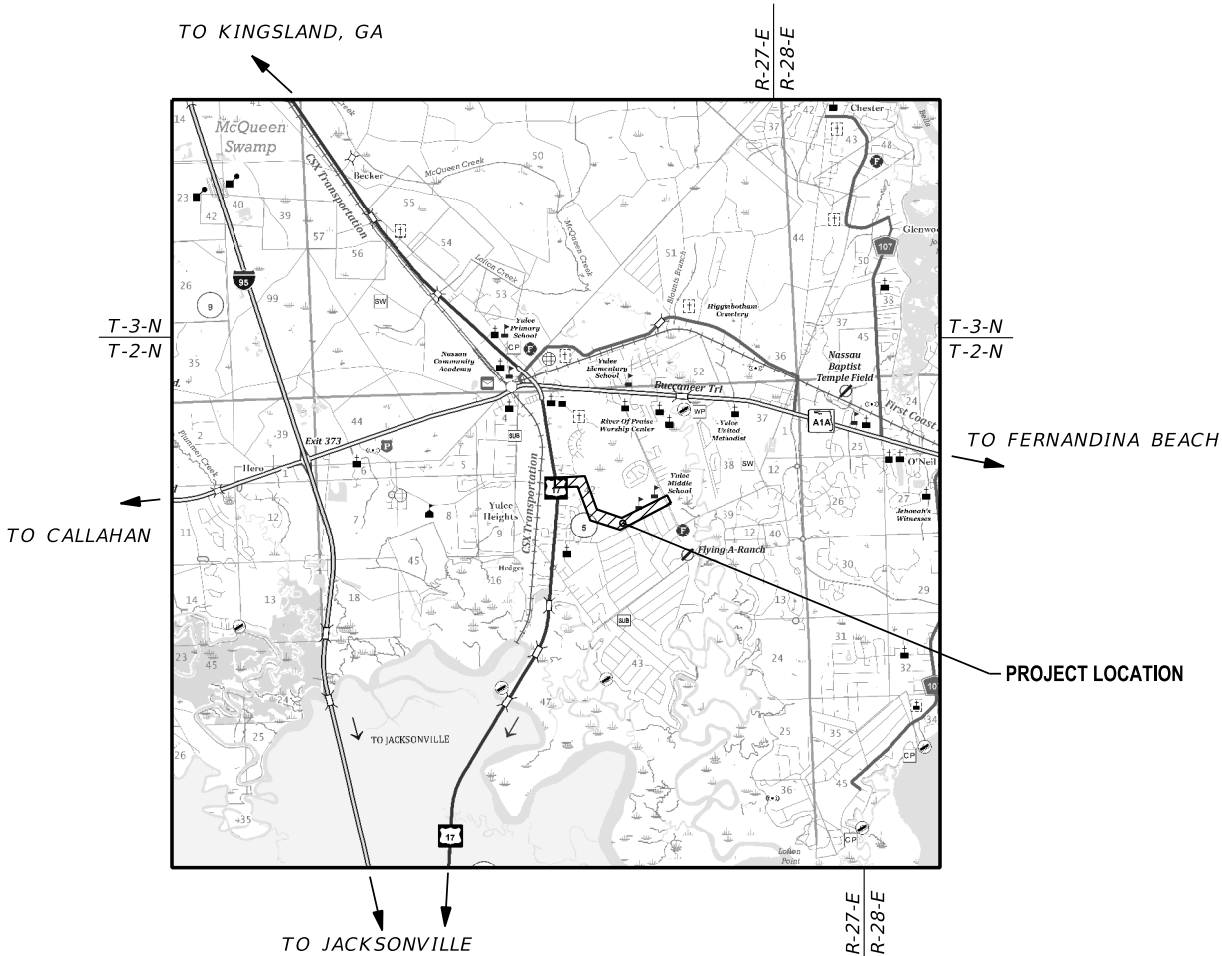

NASSAU COUNTY
BOARD OF COUNTY COMMISSIONERS

JOHN F. MARTIN, DISTRICT 1
A.M. "HUPP" HUPPMAN, DISTRICT 2
JEFF GRAY, DISTRICT 3
ALYSON MCCOLLOUGH, DISTRICT 4
KLYNT A. FARMER, DISTRICT 5

ROADWAY PLANS
ENGINEER OF RECORD:

RONALD F. HOOGLAND, P.E.
P.E. NO.: 45247
GAI CONSULTANTS, INC
12574 FLAGLER CENTER BLVD., SUITE 202
JACKSONVILLE, FL 32258
CONTRACT NO.:
VENDOR NO.: 251260999-002

NASSAU COUNTY PROJECT MANAGER:

ROBERT T. COMPANION, P.E.

GOVERNING STANDARD PLANS:

Florida Department of Transportation, FY2022/2023 Standard Plans for Road and Bridge Construction and applicable Interim Revisions (IRs).

Nassau County Ordinance 99-17, Roadway and Drainage Standards

Standard Plans for Road Construction and associated IRs are available at the following website: <http://www.fdot.gov/design/standardplans>

GOVERNING STANDARD SPECIFICATIONS:

Florida Department of Transportation, January, 2022 Standard Specifications for Road and Bridge Construction at the following website: <http://www.fdot.gov/programmanagement/Implemented/SpecBooks>


REVISIONS:

- 01 Roadway Sheets
1, 2a, 20, 31, 34, 99, 111, 112 (Revised 01/05/24)
- 02 Roadway Sheets
1, 2b, 43, 44, 84, 85, 86, 98 (Revised 01/13/25)

REVISIONS	DATE	BY	DESCRIPTION
01	1/5/24	RFH	SHEET 2a ADDED
02	1/13/25	RFH	SHEET 2b ADDED

SHEET
NO.

1

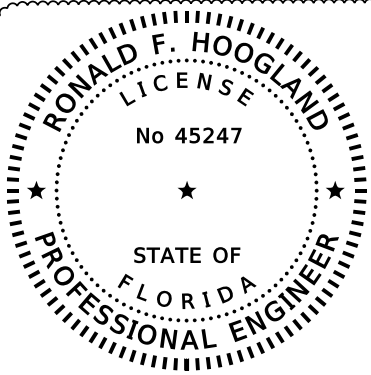

THIS ITEM HAS BEEN DIGITALLY
SIGNED AND SEALED BY:

ON THE DATE ADJACENT TO THE SEAL

PRINTED COPIES OF THIS DOCUMENT ARE
NOT CONSIDERED SIGNED AND SEALED.
THE SIGNATURE MUST BE VERIFIED
N THE ELECTRONIC DOCUMENTS.

GAI CONSULTANTS
12574 FLAGLER CENTER BLVD. SUITE 202
JACKSONVILLE, FL 32258
RONALD F. HOOGLAND, P.E. NO. 45247

THE ABOVE NAMED PROFESSIONAL ENGINEER SHALL BE RESPONSIBLE FOR THE
FOLLOWING SHEETS IN ACCORDANCE WITH RULE 61G15-23.004, F.A.C.

<u>SHEET NO.</u>	<u>SHEET DESCRIPTION</u>
1	KEY SHEET
2b	SIGNATURE SHEET
43 - 44	ROADWAY PLAN-PROFILES
84 - 86	DRAINAGE STRUCTURES
98	RETENSION/DETENTION PONDS

02

R E V I S I O N S			
REV	DATE	BY	DESCRIPTION
02	1/13/25	RFH	SHEET ADDED



gai consultants

transforming ideas into reality


12574 Flagler Center Blvd, Suite 202
Jacksonville, FL 32258
904.363.1110
Certificate of Authorization:EB9951


RONALD F. HOOGLAND, P.E. Lic. No. 45247

SCALE:	AS SHOWN
DATE:	1/13/2025
DRAWN:	JD
CHECKED:	RT
APPROVED:	RH

PROJECT NO. / DASH NO.
B190839.00
This drawing was produced with computer aided drafting technology and is supported by electronic drawing files. Do not revise this drawing via manual drafting methods.

 
SIGNATURE SHEET
WILLIAM BURGESS BLVD. EXTENSION NASSAU COUNTY, FLORIDA
2b



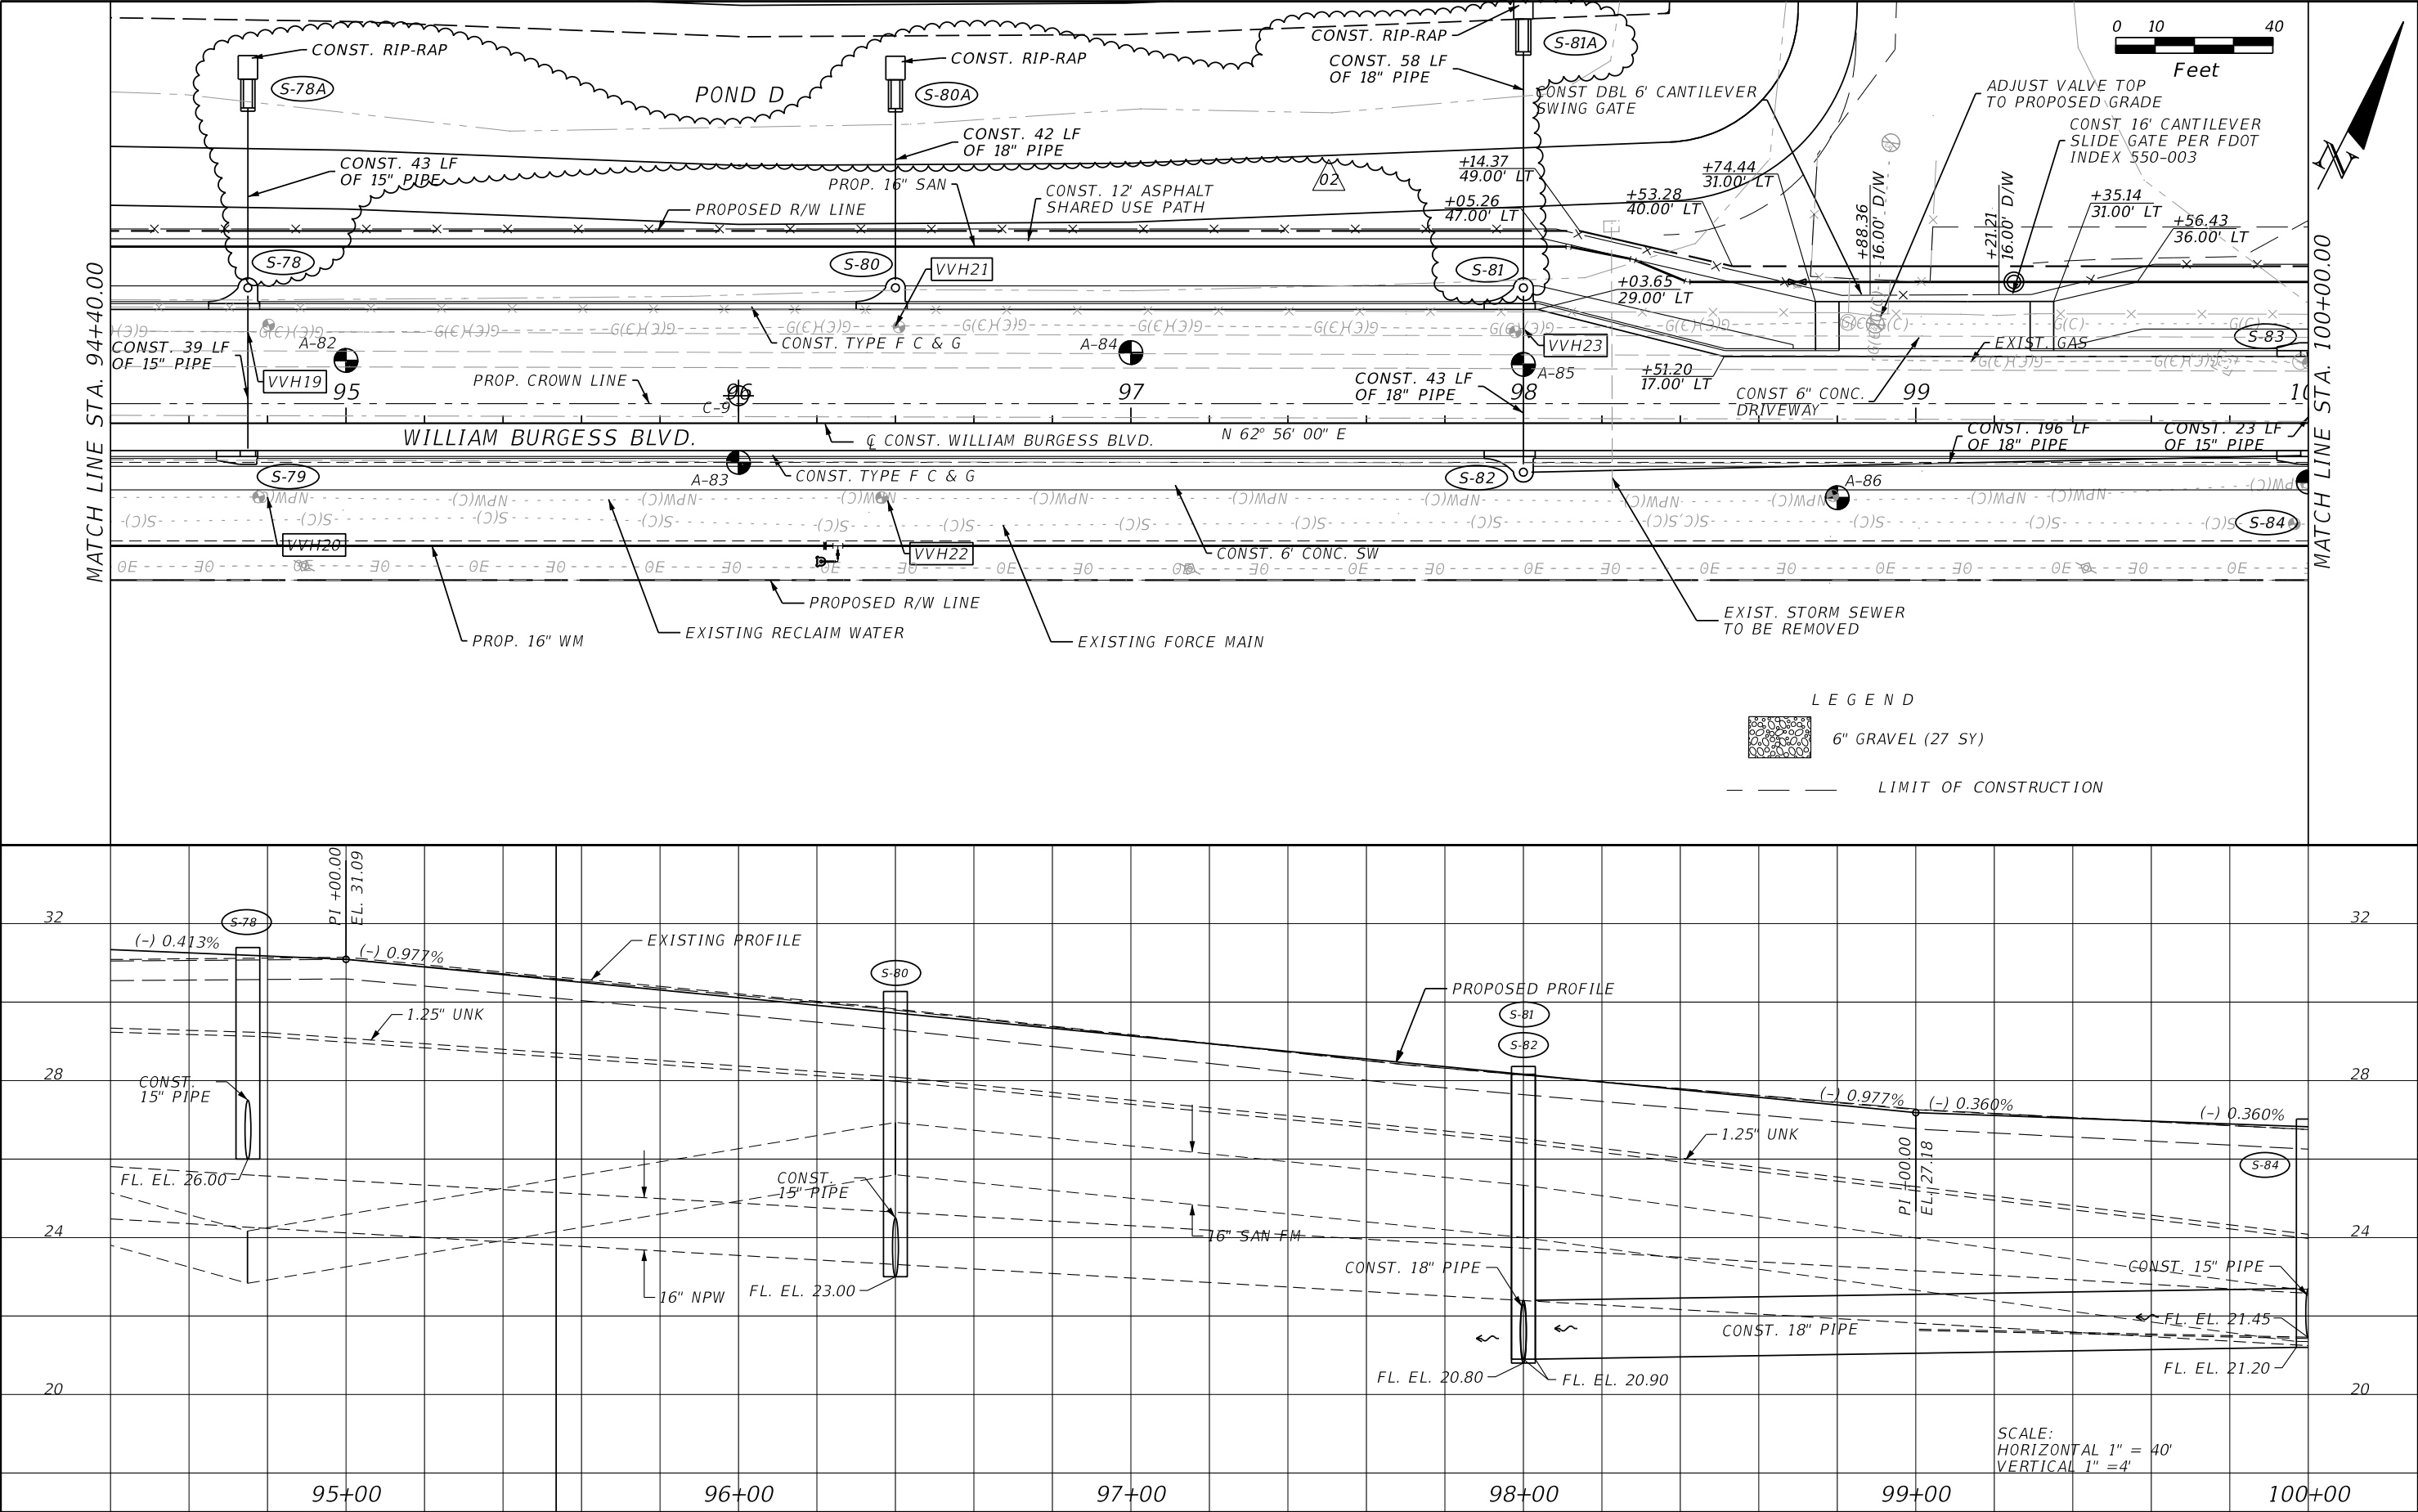


REVISIONS				PROJECT NO. / DASH NO.		PLAN AND PROFILE		SHEET NO.
REV	DATE	BY	DESCRIPTION					
02	1/13/25	RFH	STORM SEWER REVISED	DATE:	1/22/2025	B190839.00	WILLIAM BURGESS BLVD. EXTENSION NASSAU COUNTY FLORIDA	44
				DRAWN:	JD	This drawing was produced with computer aided drafting technology and is supported by electronic drawing files. Do not revise this drawing via manual drafting methods.		
				CHECKED:	RT			
				APPROVED:	RH			

THE OFFICIAL RECORD OF THIS SHEET IS THE ELECTRONIC FILE DIGITALLY SIGNED AND SEALED UNDER RULE 61G15-23.004, F.A.C.

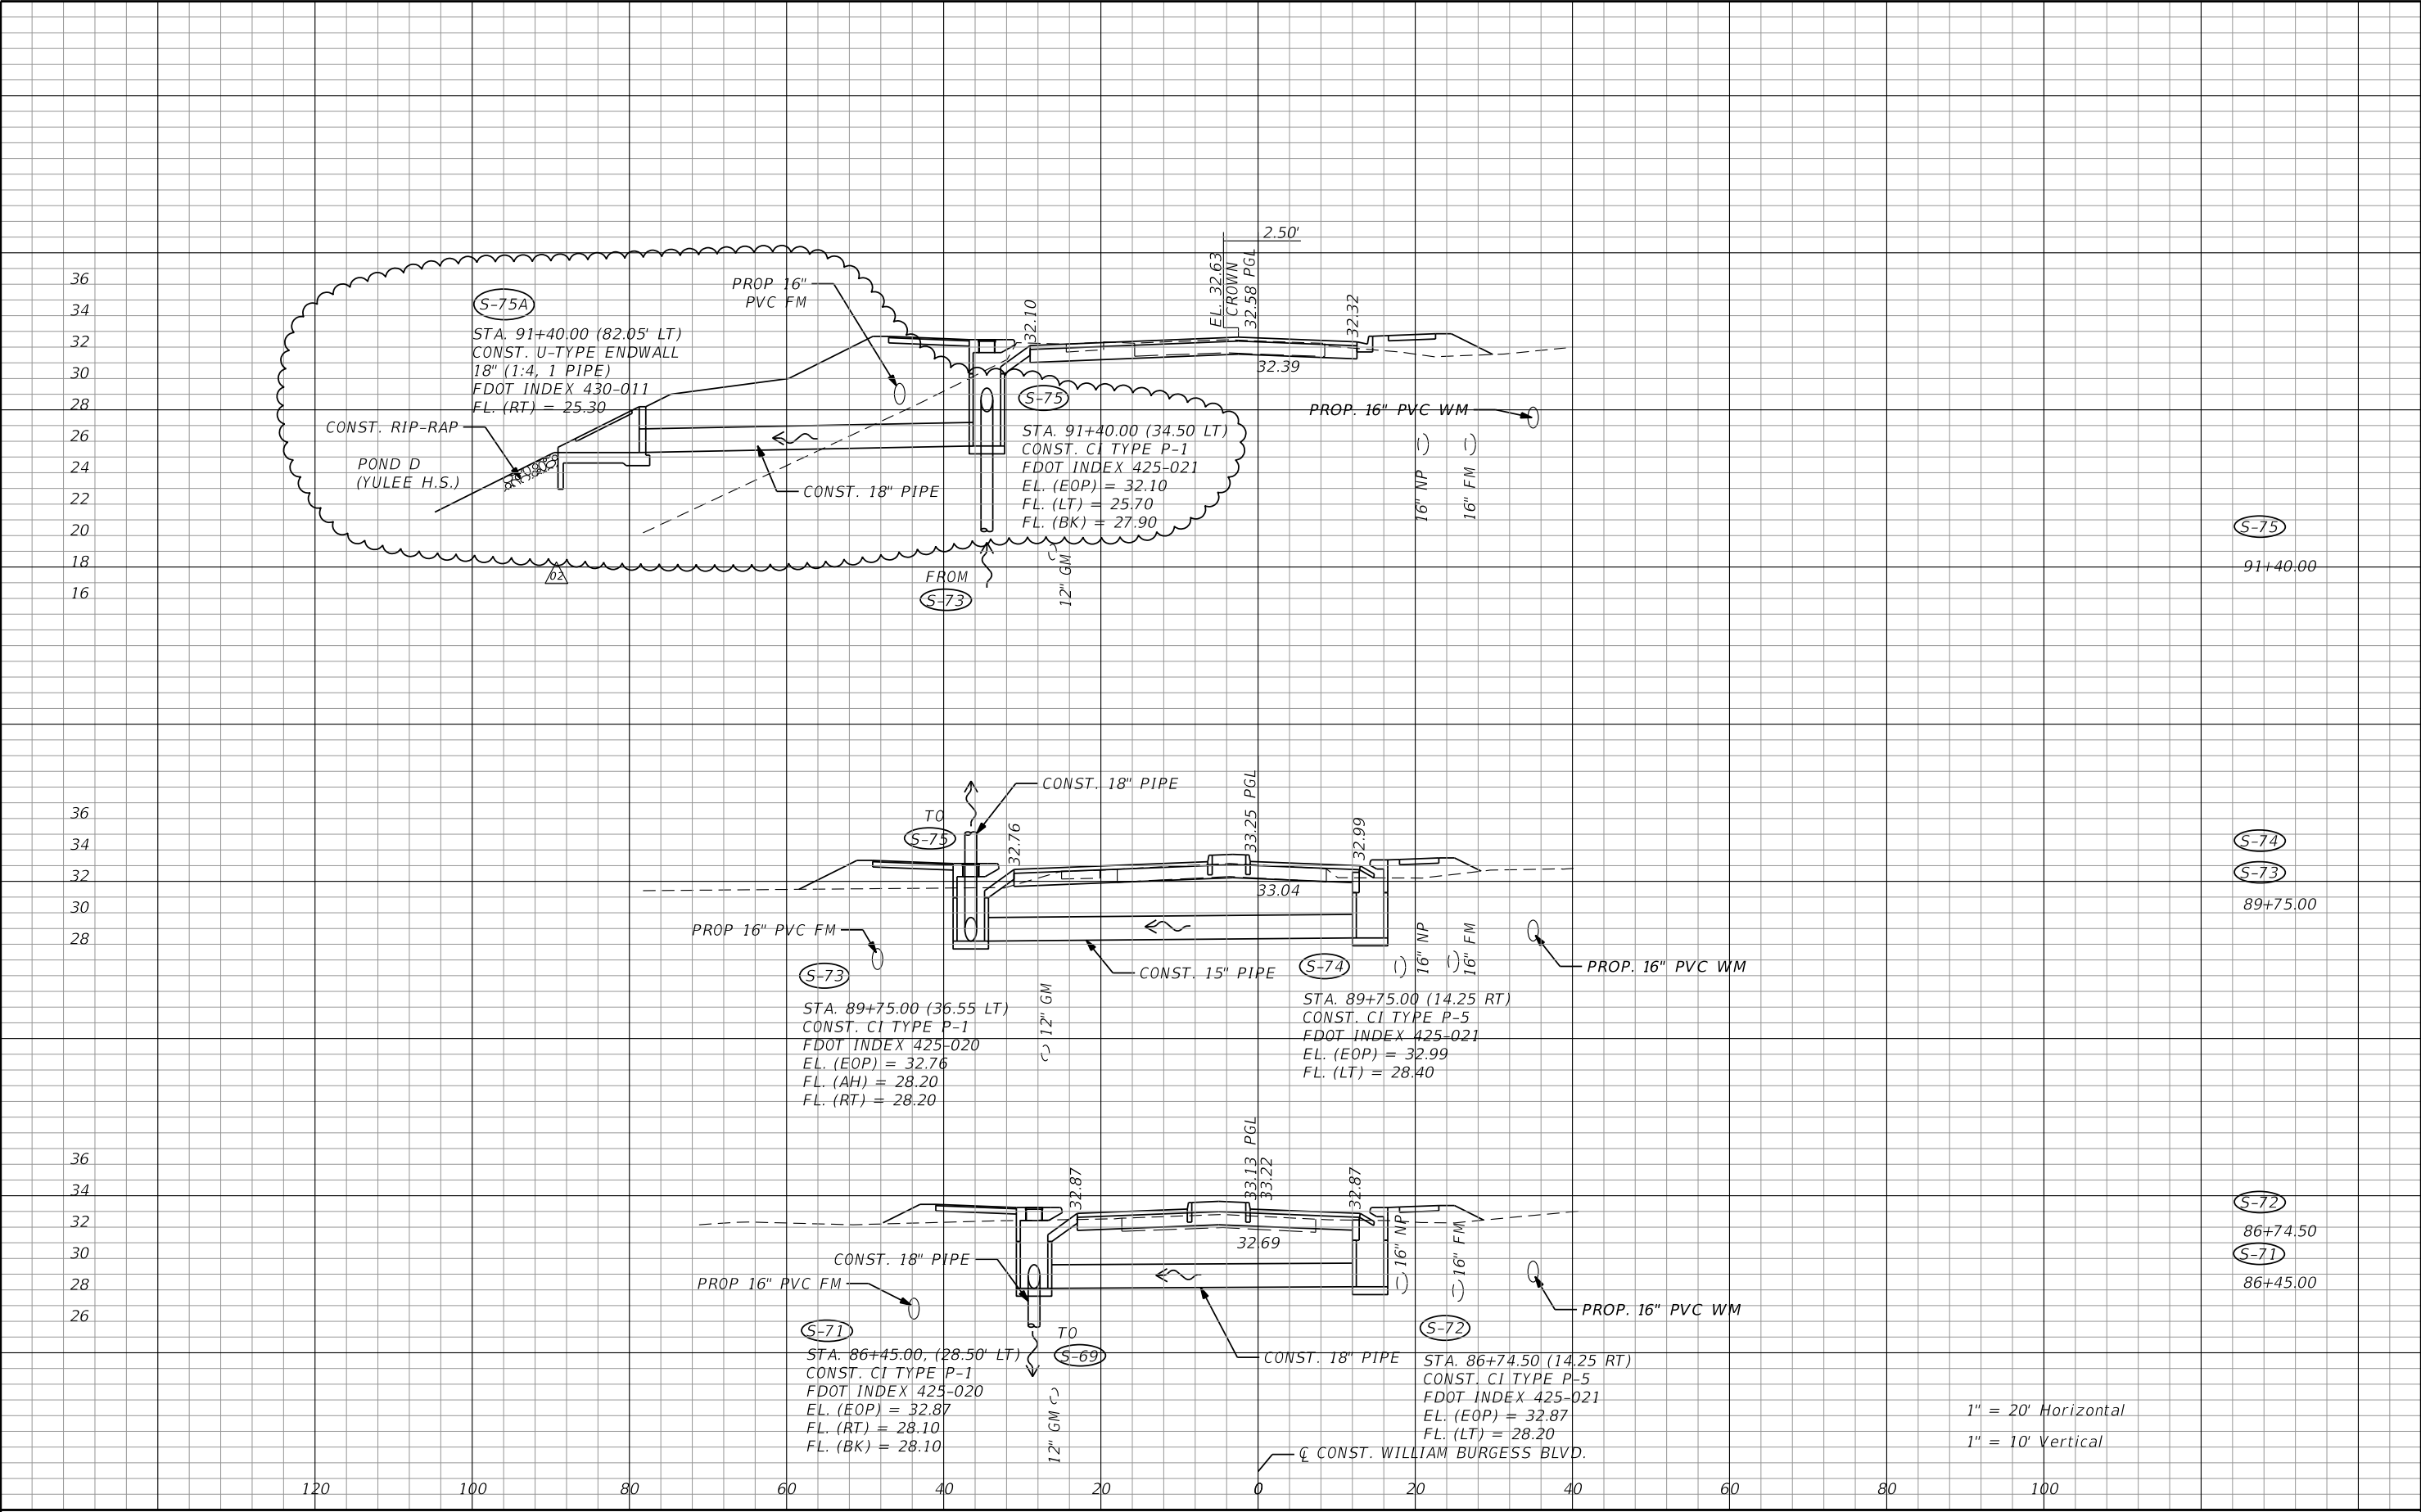

REVISIONS				 transforming ideas into reality® 12574 Flagler Center Blvd, Suite 202 Jacksonville, FL 32258 904.363.1110 Certificate of Authorization:EB9951	SCALE: AS SHOWN DATE: 1/15/2025 DRAWN: JD CHECKED: LP APPROVED: RH	PROJECT NO. / DASH NO. B190839.00	DRAINAGE STRUCTURES WILLIAM BURGESS BLVD. EXTENSION NASSAU COUNTY, FLORIDA	SHEET NO. 84
REV	DATE	BY	DESCRIPTION					
02	1/13/25	RFH	STORM SEWER ADJUSTMENT					

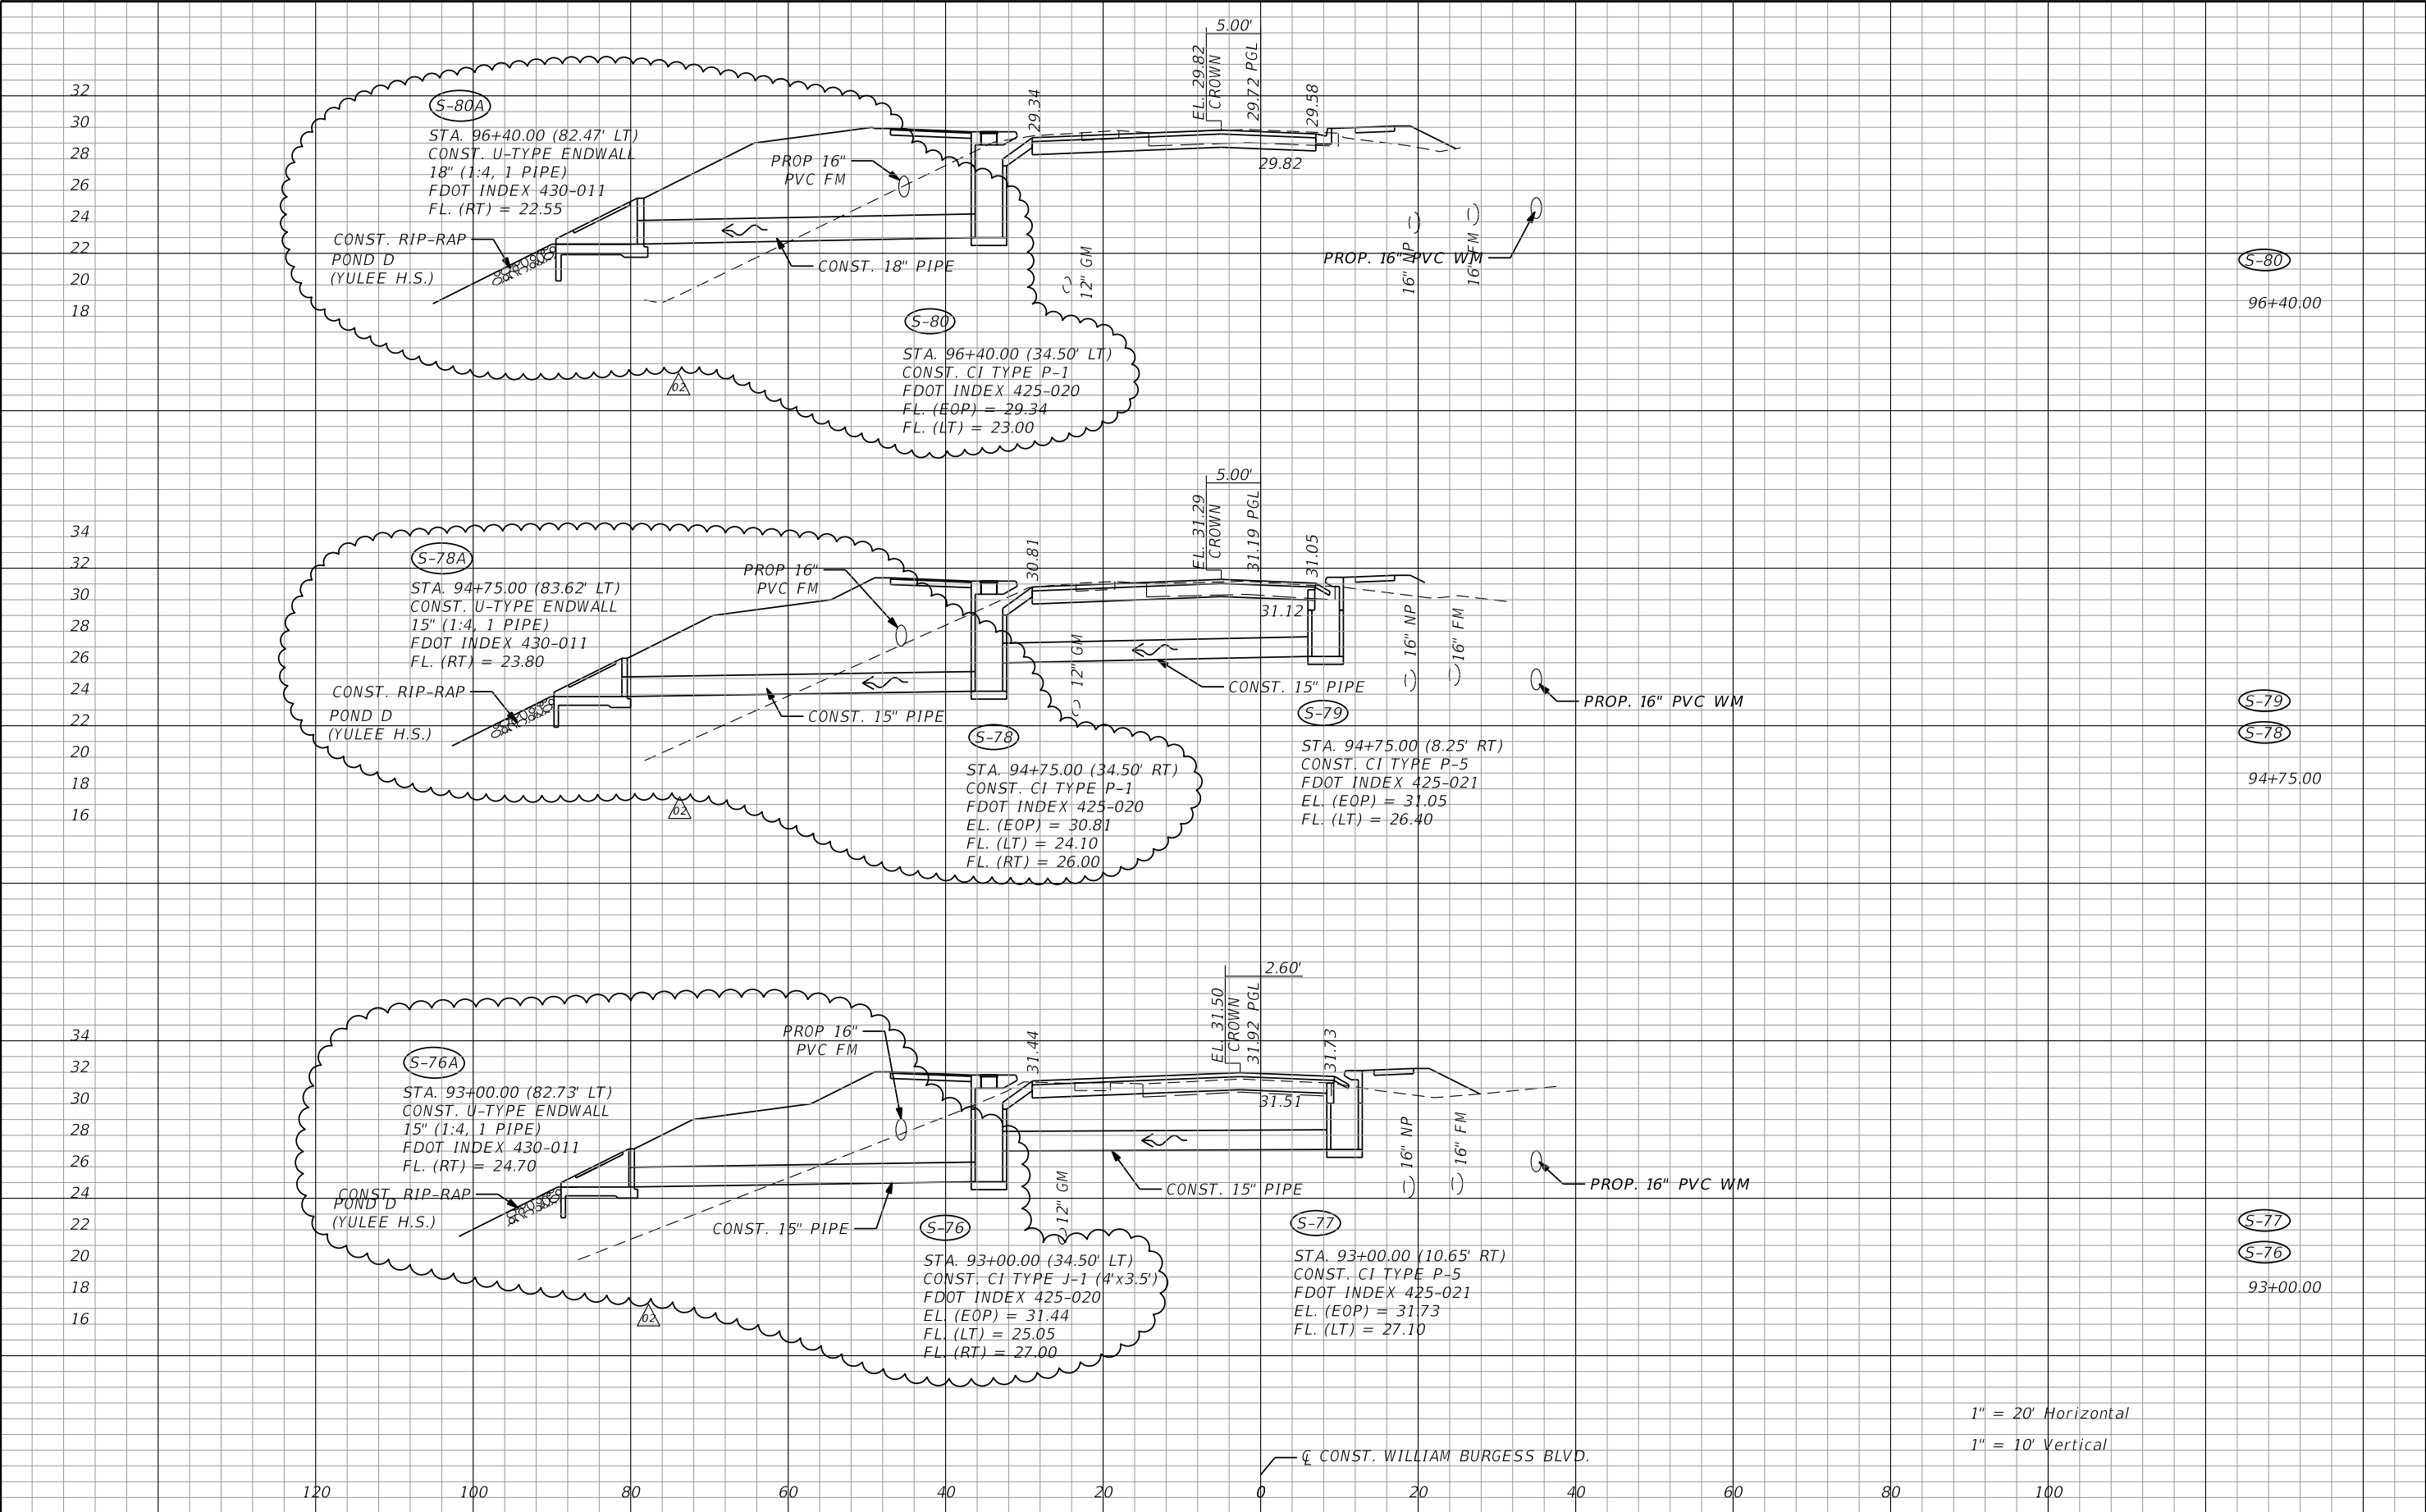


REVISIONS			
REV	DATE	BY	DESCRIPTION
02	1/13/25	RFH	STORM SEWER ADJUSTMENT



transforming ideas into reality

12574 Flagler Center Blvd, Suite 202
Jacksonville, FL 32258
904.363.1110
Certificate of Authorization:EB9951

SCALE: AS SHOWN	PROJECT NO. / DASH NO. B190839.00	DRAINAGE STRUCTURES	SHEET NO.
DATE: 1/22/2025			
DRAWN: JD	This drawing was produced with computer aided drafting technology and is supported by electronic drawing files. Do not revise this drawing via manual drafting methods.	WILLIAM BURGESS BLVD. EXTENSION NASSAU COUNTY, FLORIDA	85
CHECKED: LP			
APPROVED: RH			


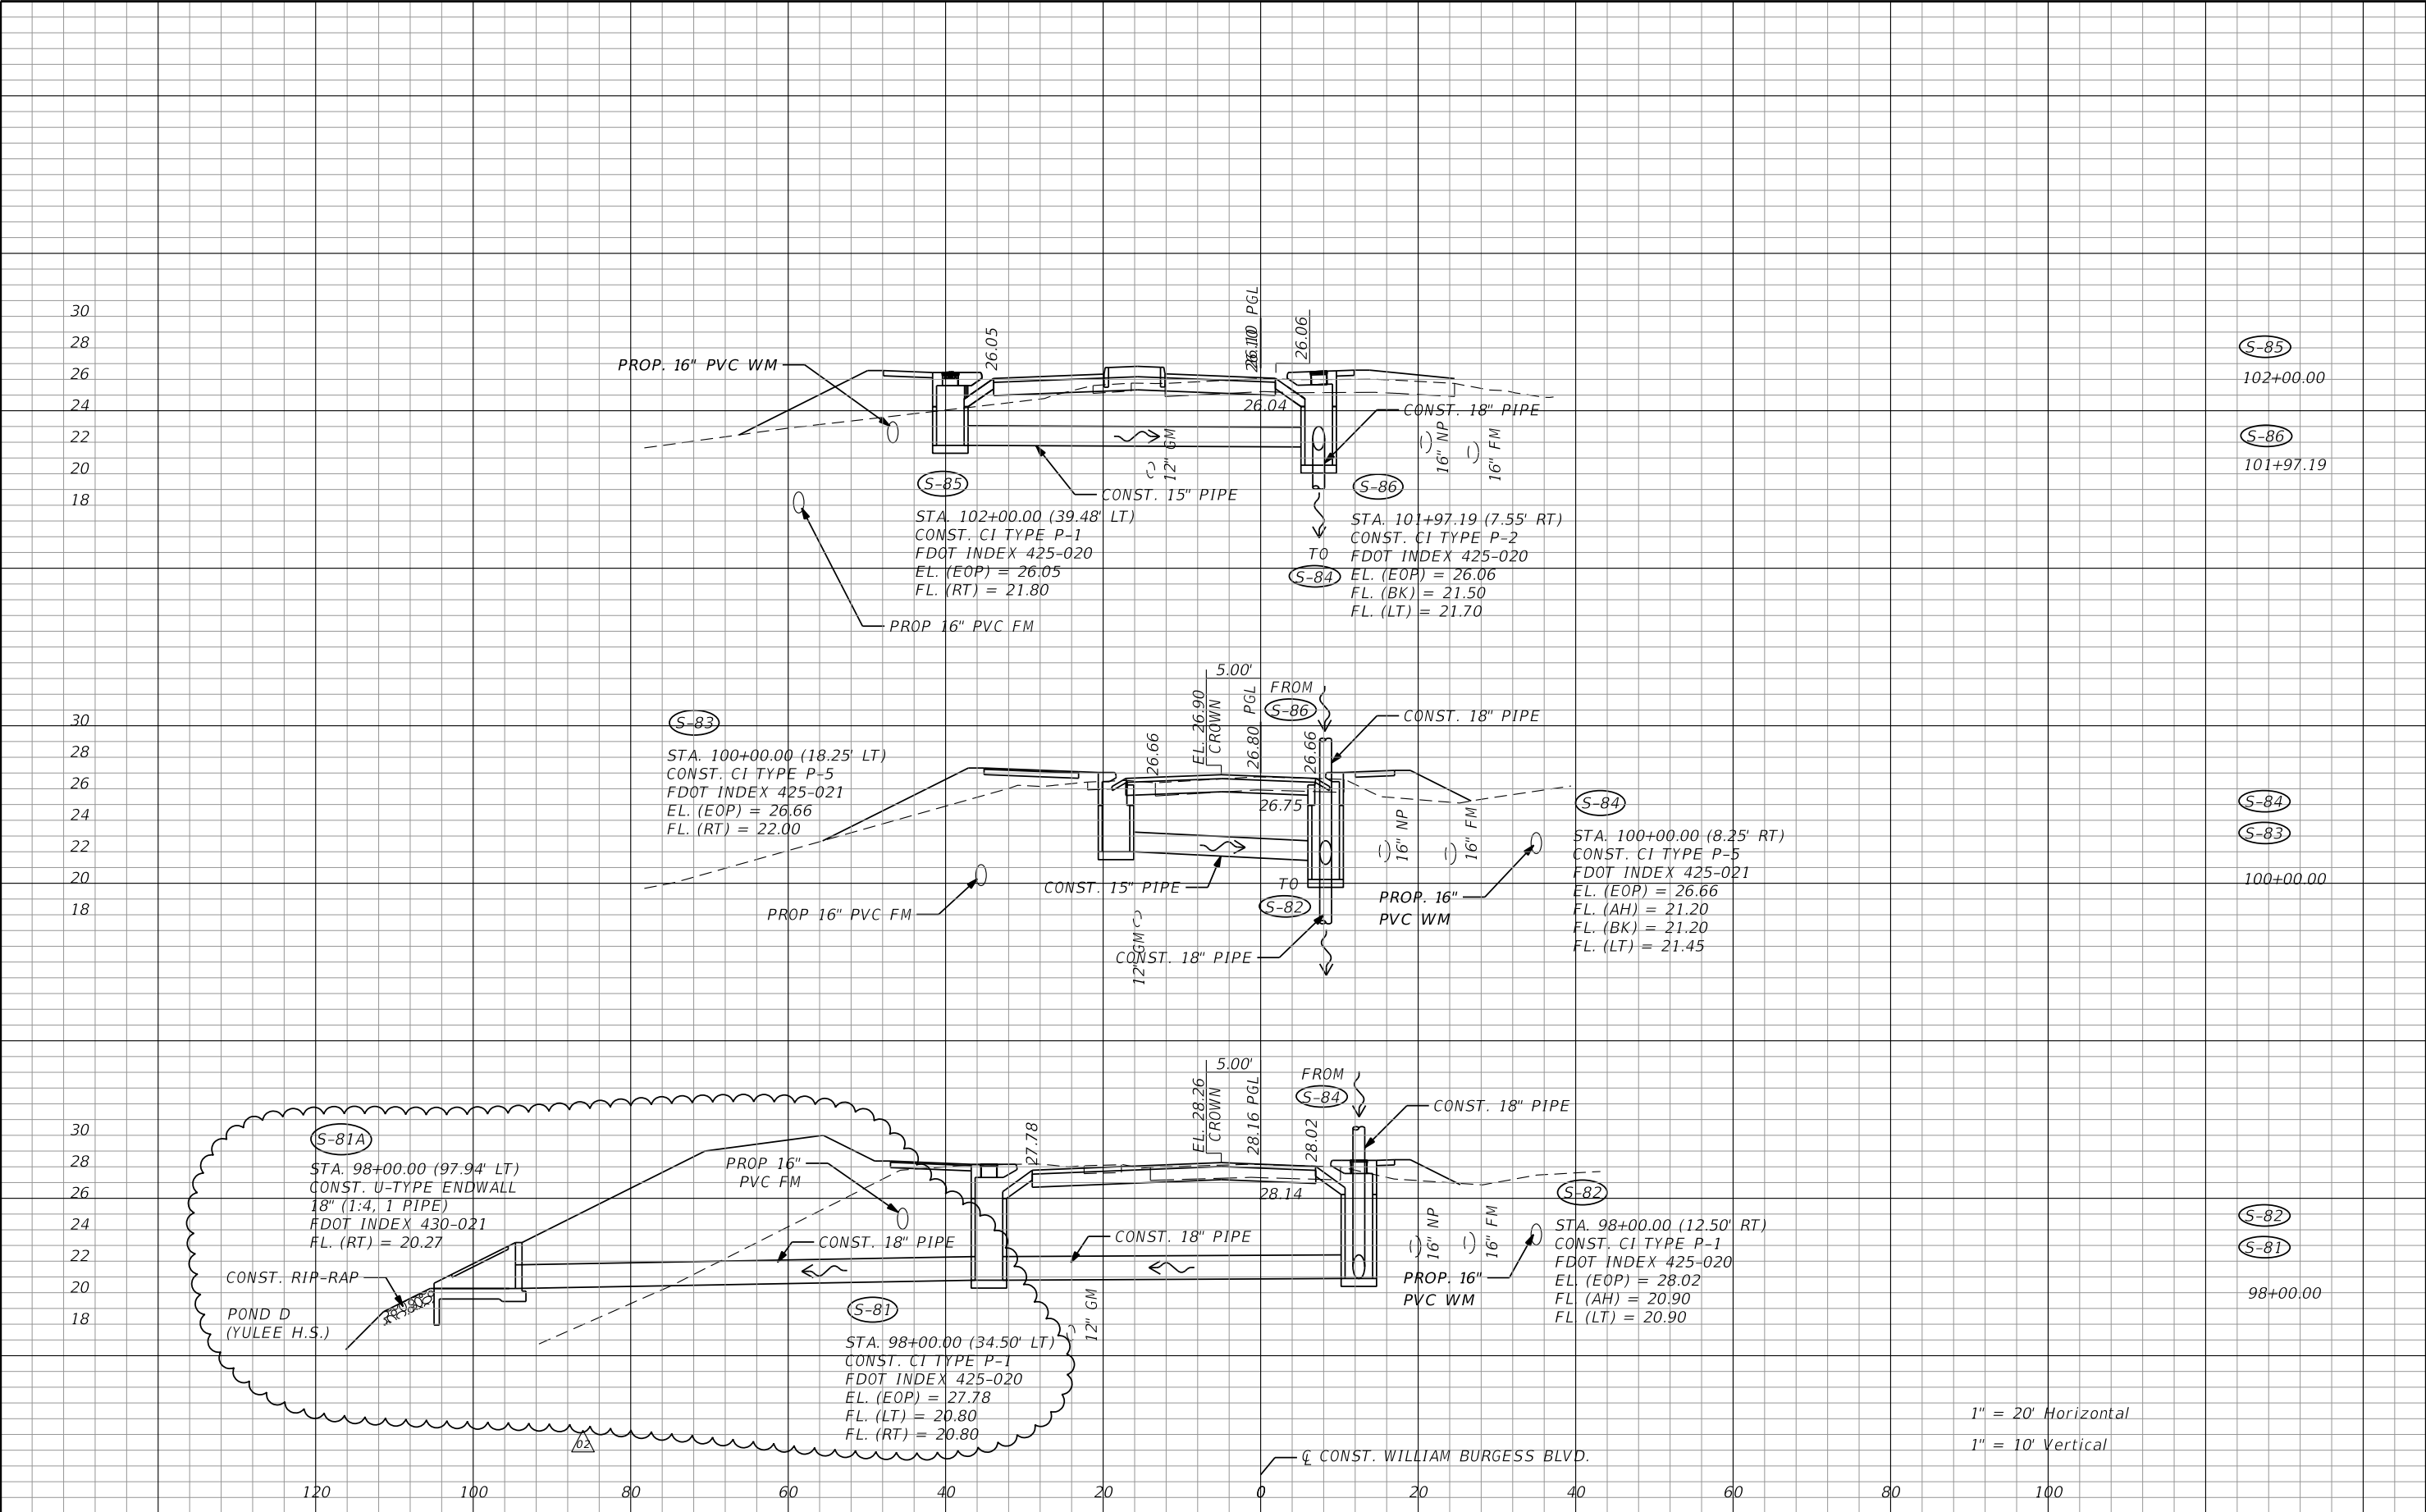


REVISIONS			
REV	DATE	BY	DESCRIPTION
02	1/13/25	RFH	STORM SEWER ADJUSTMENT



gai consultants
transforming ideas into reality®
12574 Flagler Center Blvd, Suite 202
Jacksonville, FL 32258
904.363.1110
Certificate of Authorization:EB9951

SCALE: AS SHOWN	PROJECT NO. / DASH NO. B190839.00	DRAINAGE STRUCTURES	SHEET NO.
DATE: 1/15/2025			
DRAWN: JD	This drawing was produced with computer aided drafting technology and is supported by electronic drawing files. Do not revise this drawing via manual drafting methods.		
CHECKED: LP			
APPROVED: RH		WILLIAM BURGESS BLVD. EXTENSION NASSAU COUNTY, FLORIDA	86

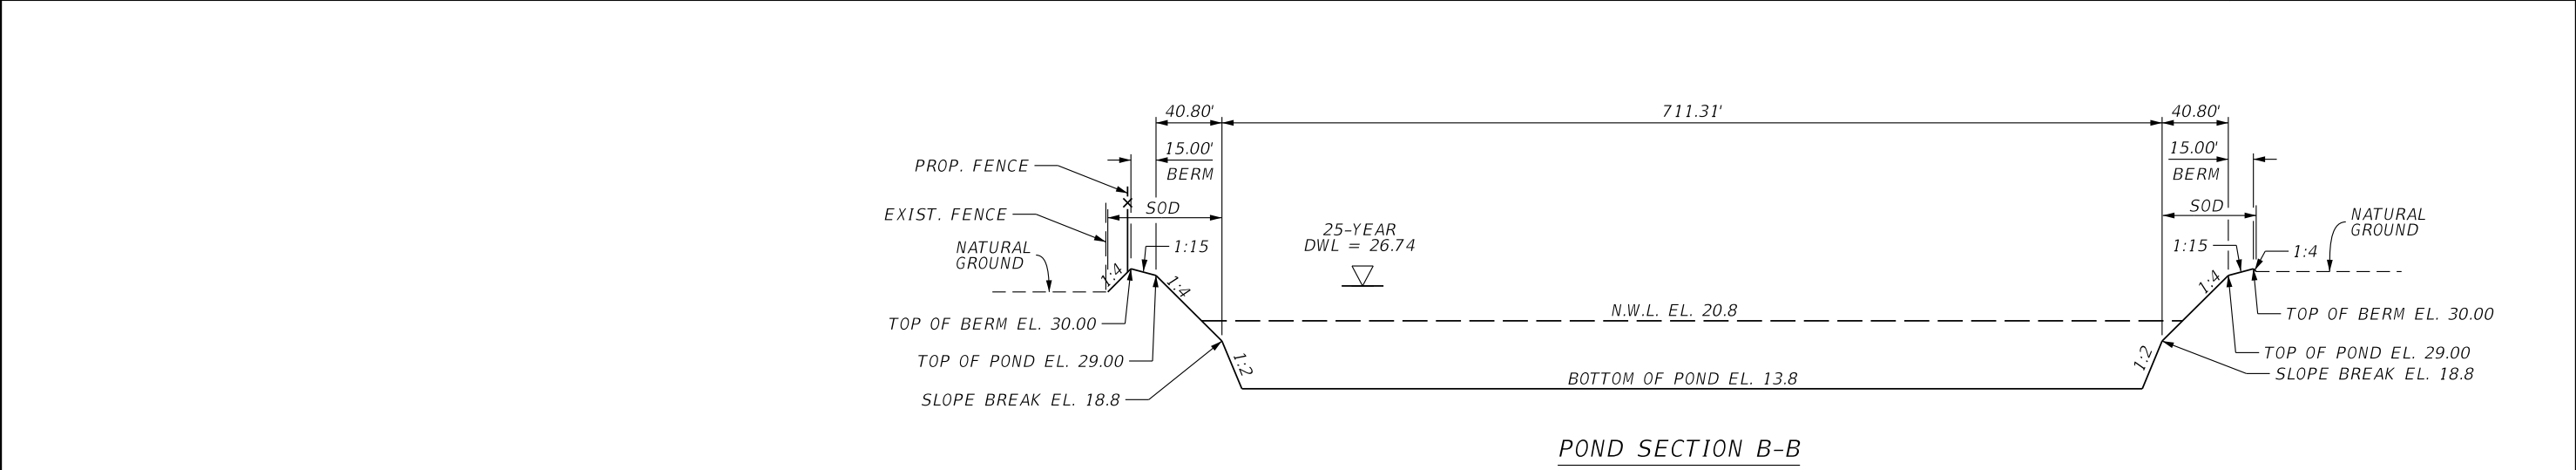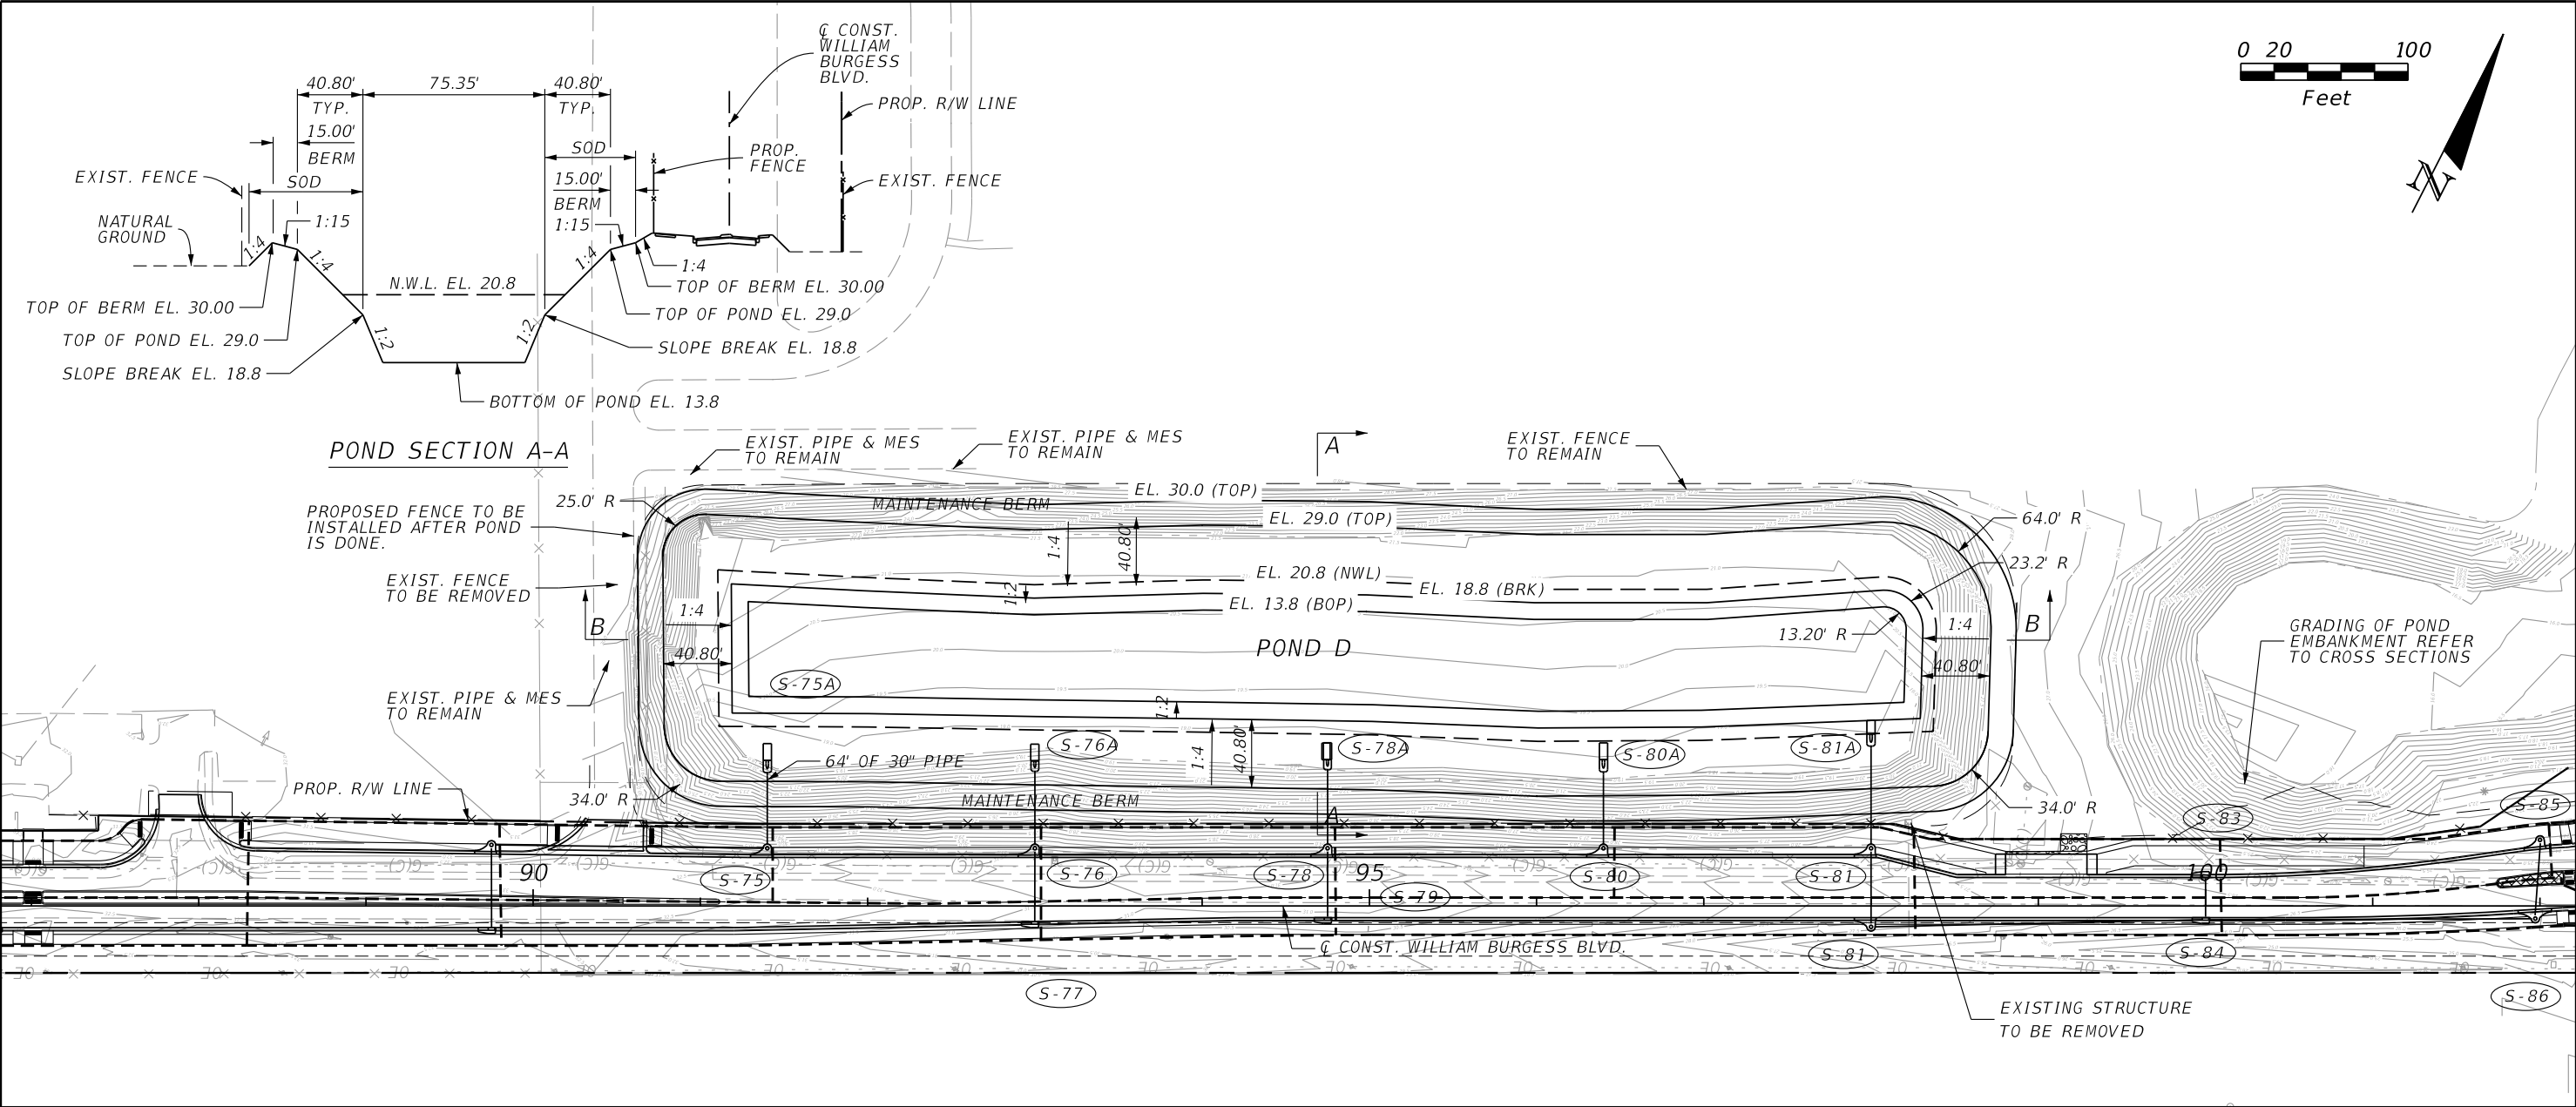

REVISIONS				gai consultants transforming ideas into reality 12574 Flagler Center Blvd, Suite 202 Jacksonville, FL 32258 904.363.1110 Certificate of Authorization:EB9951 <td data-kind="parent" data-rs="5">LAURA S. PHILLIPS, P.E. Lic. No. 54972</td> <td data-kind="parent" data-rs="5">SCALE: AS SHOWN DATE: 1/13/2025 DRAWN: JD CHECKED: RT APPROVED: RH</td> <td data-kind="parent" data-rs="5">PROJECT NO. / DASH NO. B190839.00 This drawing was produced with computer aided drafting technology and is supported by electronic drawing files. Do not revise this drawing via manual drafting methods. </td> <td data-kind="parent" data-rs="5">RETENTION/DETENTION PONDS WILLIAM BURGESS BLVD. EXTENSION NASSAU COUNTY, FLORIDA</td> <td data-kind="parent" data-rs="5">SHEET NO. 98</td>	LAURA S. PHILLIPS, P.E. Lic. No. 54972	SCALE: AS SHOWN DATE: 1/13/2025 DRAWN: JD CHECKED: RT APPROVED: RH	PROJECT NO. / DASH NO. B190839.00 This drawing was produced with computer aided drafting technology and is supported by electronic drawing files. Do not revise this drawing via manual drafting methods.	RETENTION/DETENTION PONDS WILLIAM BURGESS BLVD. EXTENSION NASSAU COUNTY, FLORIDA	SHEET NO. 98
REV	DATE	BY	DESCRIPTION						

Certificate Of Completion

Envelope Id: 42BB1E15-06F4-405E-BA3D-F9138F0FAC42

Status: Completed

Subject: Complete w/ Docusign: CM3707 - Petticoat Schmitt Civil Cont - WBEXT Change Order Approval Form CO#5

Source Envelope:

Document Pages: 20

Signatures: 5

Envelope Originator:

Certificate Pages: 3

Initials: 2

Scott Pedigo

AutoNav: Enabled

spedigo@nassaucountyfl.com

Envelopeld Stamping: Enabled

IP Address: 2601:347:8000:b

Time Zone: (UTC-05:00) Eastern Time (US & Canada)

Record Tracking

Status: Original

Holder: Scott Pedigo

Location: DocuSign

8/18/2025 10:05:19 AM

spedigo@nassaucountyfl.com

Signer Events

Signature

Timestamp

Robert Companion

RCompanion@nassaucountyfl.com

Deputy County Manager - County Engineer

Nassau County BOCC

Security Level: Email, Account Authentication
(None)

Signature Adoption: Pre-selected Style
Using IP Address: 50.238.237.26

Sent: 8/18/2025 10:16:54 AM

Viewed: 8/18/2025 11:01:13 AM

Signed: 8/18/2025 11:01:22 AM

Electronic Record and Signature Disclosure:

Not Offered via Docusign

Tracy Poore

tpoore@nassaucountyfl.com

OMB Admin

Nassau County BOCC

Security Level: Email, Account Authentication
(None)

Signature Adoption: Pre-selected Style
Using IP Address: 50.238.237.26

Sent: 8/18/2025 11:01:24 AM

Viewed: 8/18/2025 11:12:25 AM

Signed: 8/18/2025 11:16:16 AM

Electronic Record and Signature Disclosure:

Not Offered via Docusign

chris lacambra

clacambra@nassaucountyfl.com

OMB Director

Nassau County BOCC

Security Level: Email, Account Authentication
(None)

Signature Adoption: Pre-selected Style
Using IP Address: 50.238.237.26

Sent: 8/18/2025 11:16:18 AM

Viewed: 8/18/2025 11:41:53 AM

Signed: 8/18/2025 11:42:26 AM

Electronic Record and Signature Disclosure:

Not Offered via Docusign

Lanaee Gilmore

lgilmore@nassaucountyfl.com

Procurement Director

Nassau County BOCC

Security Level: Email, Account Authentication
(None)

Signature Adoption: Pre-selected Style
Using IP Address: 50.238.237.26

Sent: 8/18/2025 11:42:28 AM

Viewed: 8/19/2025 10:14:45 AM

Signed: 8/19/2025 10:14:56 AM

Electronic Record and Signature Disclosure:

Not Offered via Docusign

Signer Events	Signature	Timestamp
Abigail Jorandby ajorandby@nassaucountyfl.com Deputy County Attorney Nassau BOCC Security Level: Email, Account Authentication (None)	 Signature Adoption: Pre-selected Style Using IP Address: 50.238.237.26	Sent: 8/19/2025 10:14:58 AM Resent: 8/21/2025 3:18:46 PM Resent: 8/25/2025 10:23:31 AM Viewed: 8/27/2025 5:58:45 PM Signed: 8/27/2025 5:58:54 PM
Electronic Record and Signature Disclosure:		
Not Offered via DocuSign		
Denise C. May, Esq., BCS dmay@nassaucountyfl.com County Attorney Nassau County BOCC Security Level: Email, Account Authentication (None)	 Signature Adoption: Pre-selected Style Using IP Address: 50.238.237.26	Sent: 8/27/2025 5:58:57 PM Viewed: 8/28/2025 8:51:09 AM Signed: 8/28/2025 8:51:17 AM
Electronic Record and Signature Disclosure:		
Not Offered via DocuSign		
Taco Pope, AICP tpope@nassaucountyfl.com County Manager Nassau County BOCC Security Level: Email, Account Authentication (None)	 Signature Adoption: Drawn on Device Using IP Address: 50.238.237.26	Sent: 8/28/2025 8:51:20 AM Viewed: 8/29/2025 11:47:04 AM Signed: 8/29/2025 11:47:13 AM
Electronic Record and Signature Disclosure:		
Not Offered via DocuSign		
In Person Signer Events	Signature	Timestamp
Editor Delivery Events	Status	Timestamp
Agent Delivery Events	Status	Timestamp
Intermediary Delivery Events	Status	Timestamp
Certified Delivery Events	Status	Timestamp
Carbon Copy Events	Status	Timestamp
Capital Projects capitalprojects@nassaucountyfl.com Security Level: Email, Account Authentication (None)	COPIED	Sent: 8/29/2025 11:47:16 AM
Electronic Record and Signature Disclosure:		
Not Offered via DocuSign		
Procurement procurement@nassaucountyfl.com Security Level: Email, Account Authentication (None)	COPIED	Sent: 8/29/2025 11:47:16 AM
Electronic Record and Signature Disclosure:		
Not Offered via DocuSign		
Clerk Services BOCCclerkServices@nassauclerk.com Security Level: Email, Account Authentication (None)	COPIED	Sent: 8/29/2025 11:47:17 AM Viewed: 8/29/2025 1:14:32 PM
Electronic Record and Signature Disclosure:		

Carbon Copy Events	Status	Timestamp
Not Offered via DocuSign		
Jeremy Cronk cronkj@etminc.com Security Level: Email, Account Authentication (None) Electronic Record and Signature Disclosure: Not Offered via DocuSign	COPIED	Sent: 8/29/2025 11:47:18 AM

Witness Events	Signature	Timestamp
----------------	-----------	-----------

Notary Events	Signature	Timestamp
---------------	-----------	-----------

Envelope Summary Events	Status	Timestamps
Envelope Sent	Hashed/Encrypted	8/18/2025 10:16:54 AM
Certified Delivered	Security Checked	8/29/2025 11:47:04 AM
Signing Complete	Security Checked	8/29/2025 11:47:13 AM
Completed	Security Checked	8/29/2025 11:47:18 AM

Payment Events	Status	Timestamps
----------------	--------	------------